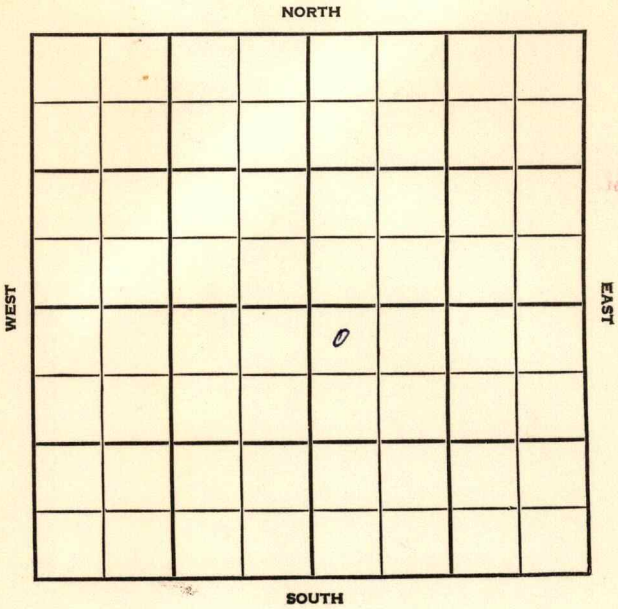


Section 8 Township 33 Range 7 EWell No. #1 RadcliffCompany Time Petroleum

Cowley

KANSAS

SEC. 8	TWP. 23 33	R. 7E
-----------	---------------	----------

WELL NO.

#1 Radcliff

FARM

COMPANY

Time Petroleum

CONTRACTOR

Kirkpatrick

Countryman Ext.


_____ Ft. from N. Line

_____ Ft. from S. Line

_____ Ft. from E. Line

_____ Ft. from W. Line

NW NW SE

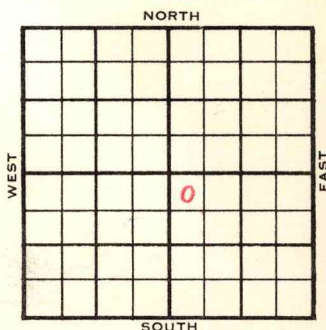

1955

ELEVATION

1234 RB, 12140F

REPORT

7/20

Comm 7-14-55

8" @100/100 Core 1725-58, Rec. 49'
 Core 1907-58, Rec 49' sand Drlg 2205,
 H²tal 1718, Layton 1898,

8-17

DST 2732-37 open 1 hr. Rec. 5' mud 0#
 DST 2740-77 open 2 hr. Rec. 30' oil
 30' ho & gcm 190/30" 5½" @ 2780/125
 Co to 2779 36/2766-72 B/ 10 go 1 hr.
 1000 A S/2½ boph 10 hr. P/ 38 bo 6 hr.
 Comp. 25 bopd
 H. Stal 1718 1718 484 L.ayton 1898
 1898 664 K.C. L. Layton 2080 2080 846
 B.K.C. Oswego 2397 2315 1081 M. Ch
 2732 2718 1484 M. LM 2738 2738 1504
 T.D. 2781

COMPLETED

County Cowley Elev. 1234 RBSec. 8 Twp. 23 33 Rge. 7ECompany Time PetroleumFarm Name Radcliff No. 1

TOPS

DEPTH

LOG

DATUM

Loc. in Sec.

Anh.

T.P.

H. Stal. 1718

Tr.

Dg.

Bl.

L. Layton 1898

K.C.

B.K.C.

Ce.

C.

M.

M.

K.

Mz.

Ma.

V.

S.

S.

A.

R.

P.E.

G.

T.D.

NW NW SE

Geol.

Contr.

Kirkpatrick

Pool

Countryman
Ext.

FIRST REPORT

JUL 20 1955

Date Comm. 7-14-558" @ 100/100 Core 1725-58 Rec. 49'Core 1907-58 Rec. 49' sand drlg. 2205

See attached
correction

SCOUT TICKET

DX-201

SEC.

8

TWP.

33

R.

7E

WELL NO.

1 Radcliff

FARM

COMPANY

Time Petroleum

CONTRACTOR

CORRECTION

NW NW SE

330

FT. FROM N. LINE


FT. FROM S. LINE

FT. FORM E. LINE

330

FT. FROM W. LINE

NORTH

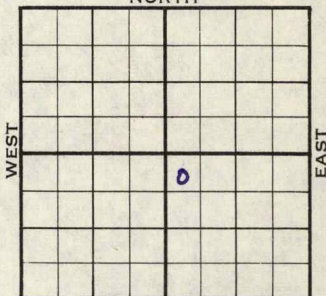

SOUTH

Cowley County

☐

LOCATION

☐

RIG UP

DRILLING AND REMARKS:

Reported

8-23-7E

RECORD

CASED IN., FT.

SAND

GAS

OIL

TOTAL DEPTH

PRODUCTION

1ST 24 HRS. NAT.

1ST 24 HRS. AFTER SHOT

GAS CU. FT.

DRY HOLE

ABANDONED

DATE

JUL 20 1955

SCOUT

L. J. Harris

County Cowley Elev. 1211 DF
1234 RB
 Sec. 8 Twp. 33 Rge. 7E
 Company Time Petroleum
 Farm Name Radcliff No. 1

TOPS	DEPTH	LOG	DATUM
Anh.			
T.P.			
H. <u>Stal</u>	<u>1718</u>	<u>1718</u>	<u>484</u>
Tr.			
Dg.			
BL.			
L. <u>ayton</u>	<u>1898</u>	<u>1898</u>	<u>664</u>
K.C. <u>L. Layton</u>	<u>2080</u>	<u>2080</u>	<u>846</u>
B.K.C. <u>Sawego</u>	<u>2397</u>	<u>2315</u>	<u>1081</u>
Ce.			
C.			
M. <u>Ch</u>	<u>2732</u>	<u>2718</u>	<u>1484</u>
M. <u>Lm</u>	<u>2738</u>	<u>2738</u>	<u>1504</u>
K.			
Mz.			
Me.			
V.			
S.			
S.			
A.			
R.			
Pe.			
G.			
T.D.	<u>2781</u>		

Loc. in Sec. NW NW SE

Geol. _____

Contr. _____

Kirkpatrick

Pool _____

Courtryman Ext



Date Comm. 7-14-55

AUG 17 1955

8" @ 100/100 core 1725-58 Rec. 49'

Core 1907-58 rec. 49' sand DST 2732-37

open 1 hr. Rec. 5' mud 0#

DST 2740-77 open 2 hr. Rec. 30' oil

30' ho & gcm 190/30" 5 1/2" @ 2780/125

CO to 2779 36/ 2766-72 B/ 10 go 1 hr.

1000 A S/ 2 1/2 boph 10 hr. P/ 38 ho

6 hr. Comp. 25 bopd