

79

Range 6

Cowley County

Wilson Farm No. 1

Smith et al Company

Sec. 5 E 33 W 33 N 9 S

Township 33


Section 9

Elev. 1333 L & S T.D. 3149


Date Drilled

Correlation by J. E. L.

1300

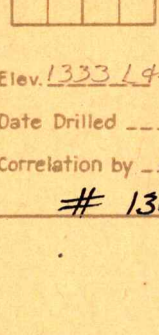

Twp.	
6	5
7	8
18	17
19	20
30	29
31	32

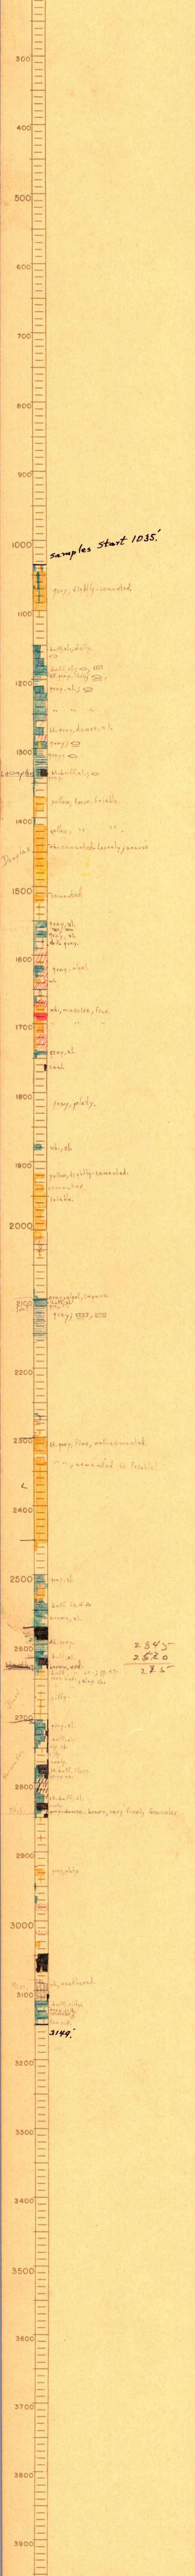

samples start 1035'

2845
2520
275