

Cowley


KANSAS

FORM 51 5M 2-38 TPCO.

Section 9 Township 33 Range 6-E

Well No. #2 Wilson

Company G. M. Smith & Pryor & Lockhart

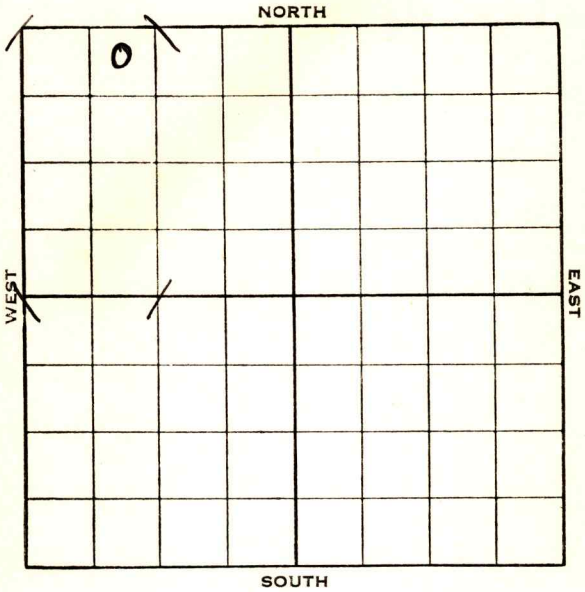

Sec. 9 Twp. 33 R. 6-E

Well No. #2 Wilson Farm

G. M. Smith & Pryor & Company


Lockhart

330 Ft. from N. Line

Ft. from S. Line

Ft. from E. Line

990 Ft. from W. Line

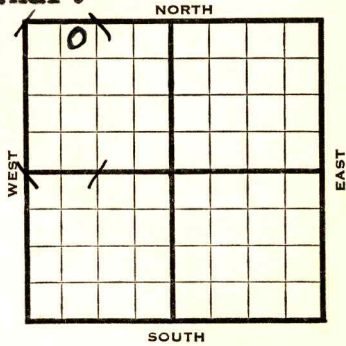

Elev. 1347

1938	REPORT
8/10	Spud.
8/19	12" - 675'. Dlg. 910'.
8/26	10" - 1390'. C. O. 1400'.
9/2	10" - 1524'. Dlg. 1715'.
9/9	8" - 1733'. T.D. 2018'.
9/16	8" - 2025'. Dlg. 2465'.
9/23	Dlg. 2850'.
9/30	Miss. 3112'. S.O. & W. 3125-33'.
	Dlg. 3190'.
10/7	Drlg. 3375'.

OVER

- 10/7--**Base Mississippi 3455**  
**Top Arbuckle 3514** T.D. ~~3517~~ 3520  
Filled up 2000 feet oil in  $1\frac{1}{2}$  hours  
Started flowing in 6 hours Flowed all  
night Averaged 35 bbls. per hour for 12  
hours 20' cavings in hole 6" set 2567  
1000' open hole Est. 43 Grav. (Tel)
- 10/14 T. D. 3520' (Corrected)  
2000' oil in  $1\frac{1}{2}$  hrs.  
Flowed 35 oil per hour.  
Gravity 41.  
5" - 3510'. WOC.
- 10/20--Drilled plugs Filled 2500' oil in  $5\frac{1}{2}$   
hours No test Shut in Will open  
today or tomorrow (Tel)
- 10/25--Slopping over estimate 5 bbls. oil per  
hour Small show water Think water  
from Mississippi Think gas from  
Mississippi Running tubing (Tel)
- 10/28 Testing.
- 11/4 Pump 200 oil in 10 hrs.
- 11/12 Testing.
- 11/18 Installing unit.
- 11/18--Potential 443 bbls. natural  
Small show water (Tel)
- 11/22 5" - 3513'.  
**Arb. 3517'.**  
T. D. 3523'.  
Pump 148 bbls. 8 hours.  
Potential 443 bbls.  
Trace of water.

COMPLETED

Map No. 2 Sec. 9 Twp. 33 R. 6E

Well No. 2 Wilson

G.M. Smith & Pryor & Lockhart  
Company

Contractor

**COMPLETED**

**SECTION PLAT**

330 **NE NW NW** Ft. from N. Line  
 \_\_\_\_\_ Ft. from S. Line  
 \_\_\_\_\_ Ft. from E. Line  
990 Ft. from W. Line

0			

Location \_\_\_\_\_

Rig up \_\_\_\_\_

Drilling and Remarks:

*Pump 148/g*  
*POT 443*  
*Trace wTr*

**RECORD**

Cased 5 in., 3513 ft.  
 Sand AMB 3517  
 Gas \_\_\_\_\_  
 Oil \_\_\_\_\_  
 Total Depth 3523

**PRODUCTION**

1st 24 hrs. Nat. \_\_\_\_\_  
 1st 24 hrs. after shot \_\_\_\_\_  
 Gas \_\_\_\_\_ Cu. Ft.  
 Dry Hole \_\_\_\_\_  
 Abandoned \_\_\_\_\_

Date

NOV 22 1938 19

H. D. Hatfield Scout

Map No. 2 Sec. 9 Twp. 33 R. 6E

Well No. 2 Wilson

G. M. Smith & Pryor & Lockhart  
Company

Contractor

FIRST REPORT

NE NW NW

330 Ft. from N. Line

\_\_\_\_\_ Ft. from S. Line

\_\_\_\_\_ Ft. from E. Line

990 Ft. from W. Line

SECTION PLAT

0			

Location \_\_\_\_\_

Rig up \_\_\_\_\_

Drilling and Remarks:

**Spud**

RECORD

Cased \_\_\_\_\_ in., \_\_\_\_\_ ft.

Sand \_\_\_\_\_

Gas \_\_\_\_\_

Oil \_\_\_\_\_

Total Depth \_\_\_\_\_

PRODUCTION

1st 24 hrs. Nat. \_\_\_\_\_

1st 24 hrs. after shot \_\_\_\_\_

Gas \_\_\_\_\_ Cu. Ft.

Dry Hole \_\_\_\_\_

Abandoned \_\_\_\_\_

Date

AUG 10 1938 19

H. D. Hatfield Scout