

KANSAS

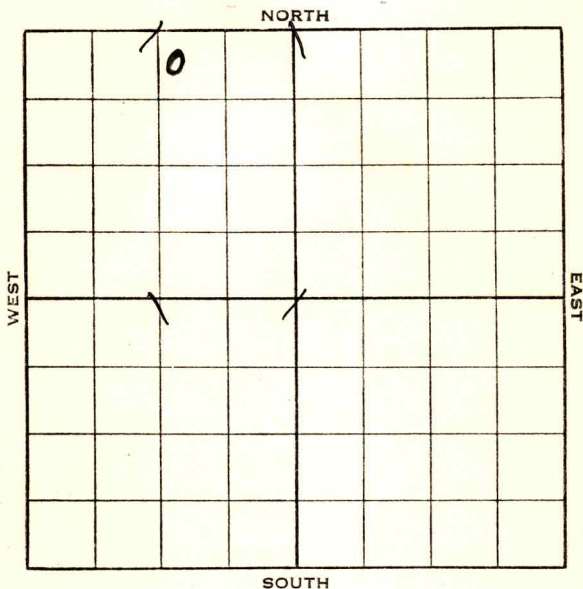
Cowley

FORM 51 5M 2-38 TPCO.

Section 9 Township 33 Range 6-E

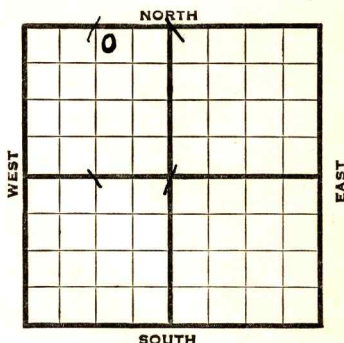
Well No. #1 Wingersbury "A"

Company Smith, Pryor & Lockhart



KANSAS

Cowley

Sec. 9 Twp. 33 R. 6-EWell No. #1 Kingsbury "A" Farm
Smith, Pryor & Lockhart Company332 Ft. from N. Line Ft. from S. Line1020 Ft. from E. Line Ft. from W. Line

Elev. 1339'.

1938	REPORT
11/9	Machine.
11/18	"
11/25	15" - 95'. Drlg. 100'.
12/2	12" - 630'. Drlg. 1065'.
12/9	10" - 1362'. T. D. 1484'.
	U. R. 10".
12/15	10" - 1520'. 8" - 1725'.
	Drlg. 1895'.
12/23	Drlg. 2200'.
12/30	Drlg. 2700'.
1939	
1/6	Chat. 3110'. S. G. 3113-23'.
	S. O. 3123-26'. Drlg. 3129'.
1/12	Top Arbuckle 3510 T.D. 3513
	1800' oil in 5 hrs. Show gas
	Flowed over pipe in 8 hrs. Shut in
	Will run 5" casing (Tel)
1/20	5" - 3506'. WOC.
1/27	T. D. 3513'. 3200' oil in 4½
	hrs. Pump 125 oil in 9 hrs.

OVER

1939

2/1 5" - 3506'.

Arb. 3510'.

T. D. 3513'.

Pump 139 bbls. 8 hrs.

Potential 417 bbls. Natural.

Show of water.

COMPLETED

Map No. 2 Sec. 9 Twp. 33 R. 6EWell No. 1 Kingsbury "A"Smith Pryor & Lockhart Company

Contractor

FIRST REPORT

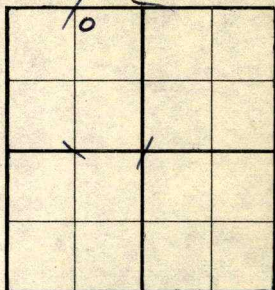
NW NE NW

332 Ft. from N. Line

Ft. from S. Line

1020 Ft. from E. Line

Ft. from W. Line

SECTION PLAT

Location _____

Rig up _____

Drilling and Remarks:

Mach.**RECORD**

Cased _____ in., _____ ft.

Sand _____

Gas _____

Oil _____

Total Depth _____

PRODUCTION

1st 24 hrs. Nat. _____

1st 24 hrs. after shot _____

Gas _____ Cu. Ft.

Dry Hole _____

Abandoned _____

Date

NOV 9 - 1938 19H. D. Hatfield Scout

Cowley

KANSAS

Map No. 2 Sec. 9 Twp. 33 R. 6EWell No. 1 Kingsbury "A"Smith, Pryor & Lockhart Company

Contractor

COMPLETED

NW NE NW

332 Ft. from N. Line

Ft. from S. Line

1020 Ft. from E. Line

Ft. from W. Line

WILSON POOL

SECTION PLAT

	0		

Location

Rig up

Drilling and Remarks:

P-139/8

Pot 417 s.w

Nat

RECORD

Cased 5 in., 3506 ft.Sand Arb 3510

Gas

Oil

Total Depth 3513

PRODUCTION

1st 24 hrs. Nat.

1st 24 hrs. after shot

Gas Cu. Ft.

Dry Hole

Abandoned

Date

FEB 1 - 1939

19

H. D. Hatfield Scout