


Cowley

Section 9 Township 33 Range 6-E

Well No. 1 Wilson

Company Gerald Smith

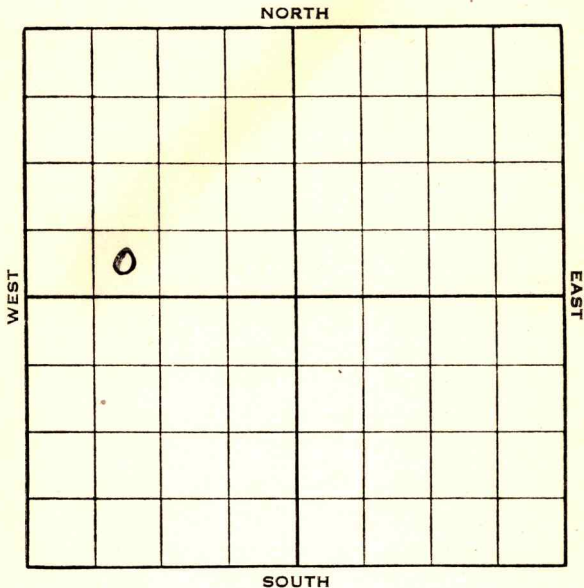

Sec. 9 Twp. 33 R. 6-E


Well No. #1 Wilson Farm  
Gerald Smith Company

\_\_\_\_\_ Ft. from N. Line

330 Ft. from S. Line

\_\_\_\_\_ Ft. from E. Line

990 Ft. from W. Line

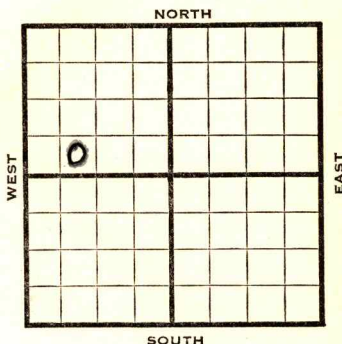

**Elev. 1333**

1938	REPORT
3/23	Drlg. 400'.
4/1	S.G. 595'. SD 800'.
4/8	Drlg. 940'.
4/15	Drlg. 1350'.
4/22	12" @ 950'. 10" @ 1545'.
	8" @ 1725'. Drlg. 1726'.
4/29	<b>Stal. 2015'</b> . Drlg. 2025'.
5/6	8" @ 2100'. C.O.
5/12	Drlg. 2448'.
5/20	Drlg. 2928'.
5/27	6" @ 2563'. <b>Miss. 3087'</b> .
	600' fluid in 48 hrs @ 3112'.
	T.D. <b>3149'</b> . May deepen.
6/3	SD 3149'.
6/10	" "
6/17	P. B. 3110'. Shot 30 qts. Est. 60 bbls. per day. 5" at 3087'. Drlg. cement.
6/24	" " " " "
7/1	5" - 3090' Shot 60 qts. 3100-3110' C.O.

OVER

1938

7/8 Cleaning out.

7/15 " "

7/22 Shut down.

7/27 5" - 3090'.

Miss. 3087'.

T. D. 3149'.

ABANDONED

Map No. 2 Sec. 9 Twp. 33 R. 6E

Well No. 1 Wilson

Gerald Smith Company

Contractor

**FIRST REPORT**

**SE SW NW**

**SECTION PLAT**

0			

\_\_\_\_\_ Ft. from N. Line

330 Ft. from S. Line

\_\_\_\_\_ Ft. from E. Line

990 Ft. from W. Line

Location \_\_\_\_\_

Rig up \_\_\_\_\_

Drilling and Remarks:

**DRIG. 400**

**RECORD**

Cased \_\_\_\_\_ in., \_\_\_\_\_ ft.

Sand \_\_\_\_\_

Gas \_\_\_\_\_

Oil \_\_\_\_\_

Total Depth \_\_\_\_\_

**PRODUCTION**

1st 24 hrs. Nat. \_\_\_\_\_

1st 24 hrs. after shot \_\_\_\_\_

Gas \_\_\_\_\_ Cu. Ft.

Dry Hole \_\_\_\_\_

Abandoned \_\_\_\_\_

Date

**MAR 23 1938** 19

**H. D. Hatfield** Scout

Cowley **KANSAS**

Map No. 2 Sec. 9 Twp. 33 R. 6E

Well No. 1 Wilson

Gerald Smith Company

Contractor

ABANDONED

SECTION PLAT

SE SW NW

\_\_\_\_\_ Ft. from N. Line

330 Ft. from S. Line

\_\_\_\_\_ Ft. from E. Line

990 Ft. from W. Line

0			

Location \_\_\_\_\_

Rig up \_\_\_\_\_

Drilling and Remarks:

DVA

RECORD

Cased 5 in., 3090 ft.

Sand MISS 3087

Gas \_\_\_\_\_

Oil \_\_\_\_\_

Total Depth 3149

PRODUCTION

1st 24 hrs. Nat. \_\_\_\_\_

1st 24 hrs. after shot \_\_\_\_\_

Gas \_\_\_\_\_ Cu. Ft.

Dry Hole \_\_\_\_\_

Abandoned \_\_\_\_\_

Date

JUL 27 1938

19

H. D. Hatfield

Scout