


KANSAS


Cowley

Section 9 Township 33 Range 7-E

Well Number 1 Olds

Company Stevens O&G

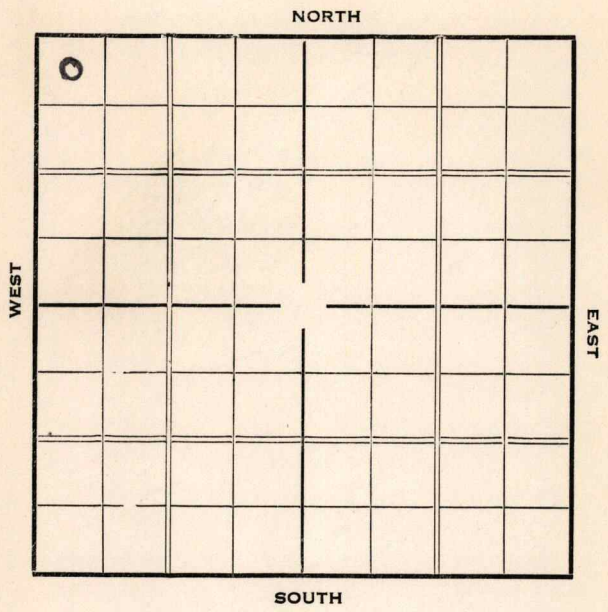

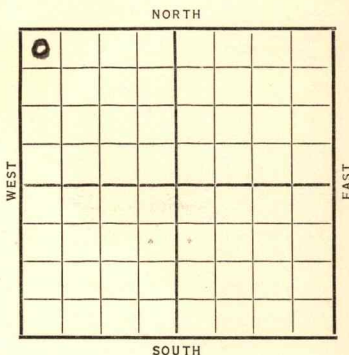COWLEY
KANSASSec. 9 Twp. 33 R. 7-EWell No. 1 Olds FarmStevens O&G Company330 Ft. from N. Line Ft. from S. Line Ft. from E. Line330 Ft. from W. Line

Date	REPORT
1937	
1/6	Location
1/14	"
1/21	R O G
1/28	Rig.
2/4	Rigging up.
2/11	" "
2/18	Drlg. 250'.
2/26	15" @ 415', Drlg. 1000'.
3/4	12" @ 1137'. Drlg. 1310'.
3/11	10" @ 1827' Drlg.
3/18	8" @ 1820'. 6" @ 2189' T.D. 2282' under ream 6".
3/25	Bart. Sd. 2751'. T. D. 2805'. 1000' oil in hole
4/2	Mississippi 2829'. Set 5" Drlg. 2874'.
4/8	Shut Down
4/16	" "
4/23	" "
4/30	" "
	OVER

1937

5/5

Bart. 2751-75'.

Miss. 2829'.

Pay 2864-74'.

T.D. 2874'.

1000 A

Pot. 35 oil.

COMPLETED

KANSAS

Map No. 3 Sec. 9 Twp. 33 R. 7EWell No. 1 DickStevens Oil Co. Company

Contractor

SECTION PLAT

0			

330 Ft. from N. Line

_____ Ft. from S. Line

_____ Ft. from E. Line

330 Ft. from W. Line

FIRST REPORT

Location ✓

Rig up _____

Drilling and Remarks:

RECORD

Cased _____ in., _____ ft.

Sand _____

Gas _____

Oil _____

Total Depth _____

PRODUCTION

1st 24 hrs. Nat. _____

1st 24 hrs. after shot _____

Gas _____ Cu. Ft.

Dry Hole _____

Abandoned _____

Date

JAN 6 1937

19

S. J. LEWIS Scout

Cowley KANSAS

Map No. 3 Sec. 9 Twp. 33 R. 7EWell No. 1 - OldsStevens O & G Company

Contractor

COMPLETED330 Ft. from N. Line

_____ Ft. from S. Line

_____ Ft. from E. Line

330 Ft. from W. Line**SECTION PLAT**

0			

Location _____

Rig up _____

Drilling and Remarks:

1000 APer 35-oil**RECORD**

Cased _____ in., _____ ft.

Sand Bart. 2751-75Gas MISS 2829Oil Pay 2864-74Total Depth 2874**PRODUCTION**

1st 24 hrs. Nat. _____

1st 24 hrs. after shot _____

Gas _____ Cu. Ft.

Dry Hole _____

Abandoned _____

Date

MAY 5 - 1937

19

H. D. Hatfield Scout

1st report shows
Sec 9

Your first report show this well to be
section 9. Check and advise
Sam

Sec. 9 is right.

H.D.H.

no wall
no sum

Returned	
Cards	<i>Paul</i>
Tracing	<i>Joe</i>
France Map	<i>Joe</i>
Scarborough Map	<i>X</i>
Moody Map	<i>X</i>
Scarborough Plat Book	
Moody Plat Book	