

Section 9 Township 33 Range 7E

Well No. #1 Olds

Company Perry Dilworth

NORTH

0							

WEST

EAST

SOUTH

Cowley

KANSAS ✓

Sec. 9 Twp. 33 R. 7E

Well No. #1 Olds Farm

Perry Dilworth Company

Crest - Contr. Contractor


400' Ft. from N. Line

\_\_\_\_\_ Ft. from S. Line

\_\_\_\_\_ Ft. from E. Line

330' Ft. from W. Line

NW NW NW (Twin Well)

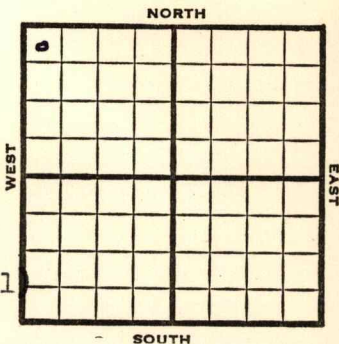

1952 **Elev. 1326'** REPORT

7/23 Spud 7-14-52  
Ring Surf  
Drlg. 2600'

7/30 Spud 7-14-52  
**Miss. 2845** TD 2855  
D&A

**ABANDONED**

County **Cowley** State **Kansas**

Sec. **9** (Blk. Twp.) **33** (Sur. Rge.) **7E** Map No.

Operator **Perry Dilworth**

Well No. **1** Farm **Olds**

Elev. Location **NW NW NW (twin well)**

o					

**400** Ft. From **N** Line **NW**

**330** Ft. From **W** Line **Quarter**

1st. Report **JUL 23 1952**

Completion

Remarks


**Crest - Contr.**

Spudding Date **7-14-52**

FIRST REPORT

Drlg. Data

**ring surf.** drlg. 2600

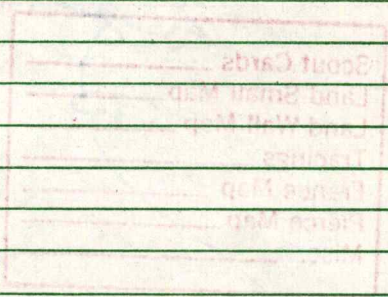

J. G. MCGEHEE

County Cowley State Kansas  
 Sec. 9 (Blk. 33 (Sur. 7E (Rge.) Map No.  
 Operator Perry Dilworth  
 Well No. 1 Farm Olds  
 Elev. 1326 Location NW NW NW (twin well)

0					

400 Ft. From N Line NW  
330 Ft. From W Line Quarter  
 Ist. Report \_\_\_\_\_  
 Completion JUL 30 1952  
 Remarks \_\_\_\_\_  
Crest - Contr.  
 Spudding Date 7-14-52

Drilg. Data  
Miss. 2845 TD 2855 D & A