211184

TYPE

SIDE ONE

AFFIDAVIT OF COMPLETION FORM

ACO-1 WELL HISTORY

★ 5-33-96 Compt.____

(Rules 82-3-130 and 82-3-107) DOCKET NO. NP_____

This form shall be filed with the Kansas Corporation Commission, 200 Colorado Derby Building, Wichita, Kansas 67202, within ninety (90) days after the completion of a well, regardless of how the well was completed.

FOR INFORMATION REGARDING THE NUMBER OF COPIES TO BE FILED AND APPLICATIONS REQUIRING COPIES OF ACO-1 FORMS SEE PAGE TWO (2), SIDE TWO (2) OF THIS FORM.

(F) X Letter requesting confidentiality attached.

C X Attach ONE COPY of EACH wireline log run (i.e. electrical log, sonic log, gamma ray neutron log etc.)***Check here if NO logs were run _____.

PLEASE FILL IN ALL INFORMATION. IF NOT AVAILABLE, INDICATE. IF INFORMATION LATER BECOMES AVAILABLE, SUBMIT BY LETTER.

LICENSE # 5084 EXPIRATION DATE 7-1-1984

OPERATOR Four Sands Oil API NO. 15-019-24,458

ADDRESS P.O. Box 310 COUNTY Chautauqua

Sedan, KS 67361 FIELD Wildcat

** CONTACT PERSON Bob Hopkins PROD. FORMATION None

PHONE 316 725-5602 _____ Indicate if new pay.

PURCHASER None LEASE Goode ✓

ADDRESS _____ WELL NO. 6

_____ WELL LOCATION SE NW SE

DRILLING CONTRACTOR EDCO Drilling Co. 1815 Ft. from S Line and

ADDRESS P.O. Box 645 1620 Ft. from E Line of


El Dorado, KS 67042 the SE (Qtr.) SEC 5 TWP 33 RGE 9 (E) (W).

PLUGGING CONTRACTOR EDCO Drilling Co.

ADDRESS P.O. Box 645

El Dorado, KS 67042

WELL PLAT

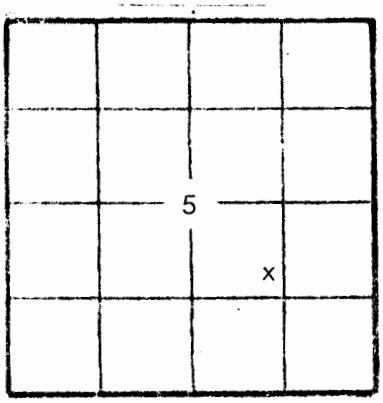

(Office Use Only)

KCC ____

KGS ✓

SWD/REP ____

PLG. ____

NGPA ____

TOTAL DEPTH 2112' PBTD --

SPUD DATE 1-26-84 DATE COMPLETED 2-1-84

ELEV: GR 1076 DF -- KB 1081

DRILLED WITH (CABLE) (ROTARY) (AIR) TOOLS.

DOCKET NO. OF DISPOSAL OR REPRESSURING WELL BEING USED TO DISPOSE OF WATER FROM THIS LEASE None .

Amount of surface pipe set and cemented 42' DV Tool Used? No .

TYPE OF COMPLETION THIS AFFIDAVIT APPLIES TO: (Circle ONE) - Oil, Shut-in Gas, Gas, Dry, Disposal, Injection, Temporarily Abandoned. If OWWO, indicate type of re-completion _____. Other completion _____. NGPA filing _____.

ALL REQUIREMENTS OF THE STATUTES, RULES AND REGULATIONS PROMULGATED TO REGULATE THE OIL AND GAS INDUSTRY HAVE BEEN FULLY COMPLIED WITH.

A F F I D A V I T

Robert T. Hopkins, being of lawful age, hereby certifies that:

I am the Affiant, and I am familiar with the contents of the foregoing Affidavit. The statements and allegations contained therein are true and correct.

ACO-1 Well History

Side TWO 15-033-20,276 (E)
OPERATOR Four Sands Oil LEASE NAME Goode SEC 5 TWP 33 S RGE 9 (W)
WELL NO 6

FILL IN WELL INFORMATION AS REQUIRED:

Show all important zones of porosity and contents thereof; cored intervals, and all drill-stem tests, including depth interval tested, cushion used, time tool open, flowing and shut-in pressures, and recoveries.

Show Geological markers, logs run, or other Descriptive information.

Formation description, contents, etc.	Top	Bottom	Name	Depth
X Check if no Drill Stem Tests Run. Check if samples sent Geological Survey.				
Shale and lime	0	288		
Lime	288	312		
Shale	312	556		
Lime	556	578		
Shale	578	654		
Sand	654	714		
Shale and Lime	714	1328		
Sand	1328	1504		
Lime and sand	1504	1667		
Shale and lime streaks	1667	1785		
Lime	1785	1812		
Shale	1812	1885		
Lime	1885	1980		
Shale	1980	2112	RTD	
At RTD, plug and abandon after G-N log				

If additional space is needed use Page 2

Report of all strings set --- surface, intermediate, production, etc. CASING RECORD (New) or (Used)

Purpose of string	Size hole drilled	Size casing set (in O.D.)	Weight lbs/ft.	Setting depth	Type cement	Sacks	Type and percent additives
Surface	12¼"	8 5/8"	25	42'	Portland	50	3% $CaCl_2$

LINER RECORD			PERFORATION RECORD		
Top, ft.	Bottom, ft.	Sacks cement	Shots per ft.	Size & type	Depth interval

TUBING RECORD					
Size	Setting depth	Packer set at			