


KANSAS

Section 1 Township 34
33 Range 2E

Well No. #1 Cradit

Company Lance C. Hill et al

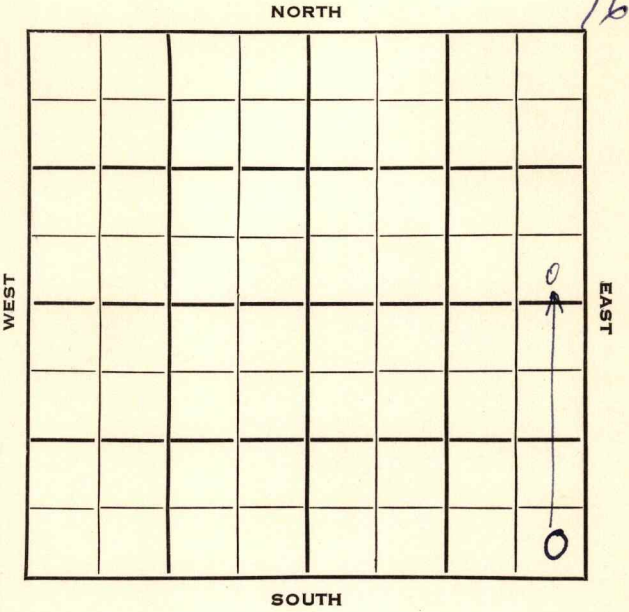

Sumner

KANSAS

2E

Sec. 1 Twp. 34 R. 33Well No. #1 Gradit FarmLance C. Hill et al CompanyWakefield Contractor
Wildcat.

Ft. from N. Line


330

Ft. from S. Line

330

Ft. from E. Line

Ft. from W. Line

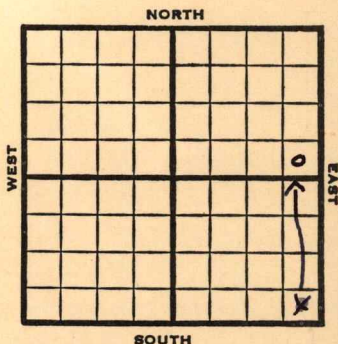SE SE ~~SE~~ ^{NE}

1953

Elev. 1108'

REPORT

7/14

Location

7/29

Spud 7-19-53

D&A

TD 3435

8" @ 105

Br line 2239, Stal 2275, KC 2689,

Layton 2740, B. Ft. Scott 3190,

Cong 3402, Miss 3408

TD 3435

D&A

ABANDONED

County Sumner State KansasSec. 1 (Blk.) 33 (Sur.) 2E Map No.Operator Lance C. Hill, etal.Well No. 1 Farm CreditElev. _____ Location SE SE SE

330 Ft. From S Line SE330 Ft. From E Line Quarter1st. Report JUL 14 1953

Completion _____

Remarks _____

Wakefield - Contr.

Spudding Date _____

Drlg. Data WildcatLocation

J. G. McGEHEE


Kansas

Map No. _____ Sec. 1 Twp. 34 R. 2EWell No. 1 CreditLance C. Hill et al. Company**CORRECTION**

Contractor

SE SE SE

SECTION PLAT

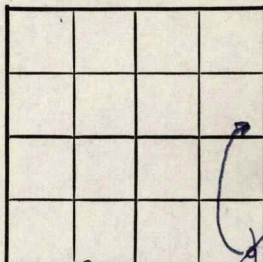

_____ Ft. from N. Line

330 Ft. from S. Line330 Ft. from E. Line

_____ Ft. from W. Line

Sumner County*See aban ticket*

Location _____

Rig up _____

~~Drilling and Remarks:~~Reported
1-33-2E

RECORD

Cased _____ in., _____ ft.

Sand _____

Gas _____

Oil _____

Total Depth _____

PRODUCTION

1st 24 hrs. Nat. _____

1st 24 hrs. after shot _____

Gas _____ Cu. Ft.

Dry Hole _____

Abandoned _____

Date


JUL 29 1953

19

J. G. McGEHEE

Scout

County Sumner State Kansas
 Sec. 1 (Blk.) 34 (Sur.) 2E Map No.
 Operator Lance C. Hill et al.
 Well No. 1 Farm Credit
 Elev. 1108 Location SE SE SE NE

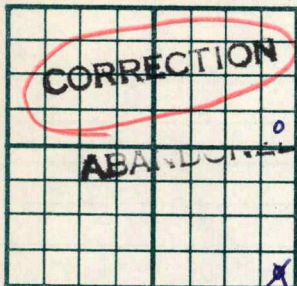

330 Ft. From S Line SE-NE
 330 Ft. From E Line Quarter

1st. Report

Completion JUL 29 1953

Remarks Wildcat

Wakefield - Contr.

Spudding Date 7-19-53

Drilg. Data D & A TD 3435

8" @ 105 Br. lime 2239 Stal. 2275

KC 2689 Layton 2740 B. Ft. Scott 3190

Cong. 3402 Miss. 3408 TD 3435

D & A