


Section 1 Township 34 Range 2E

Well No. #1 Gueda Springs Block 10

Company McNeish & Gralapp

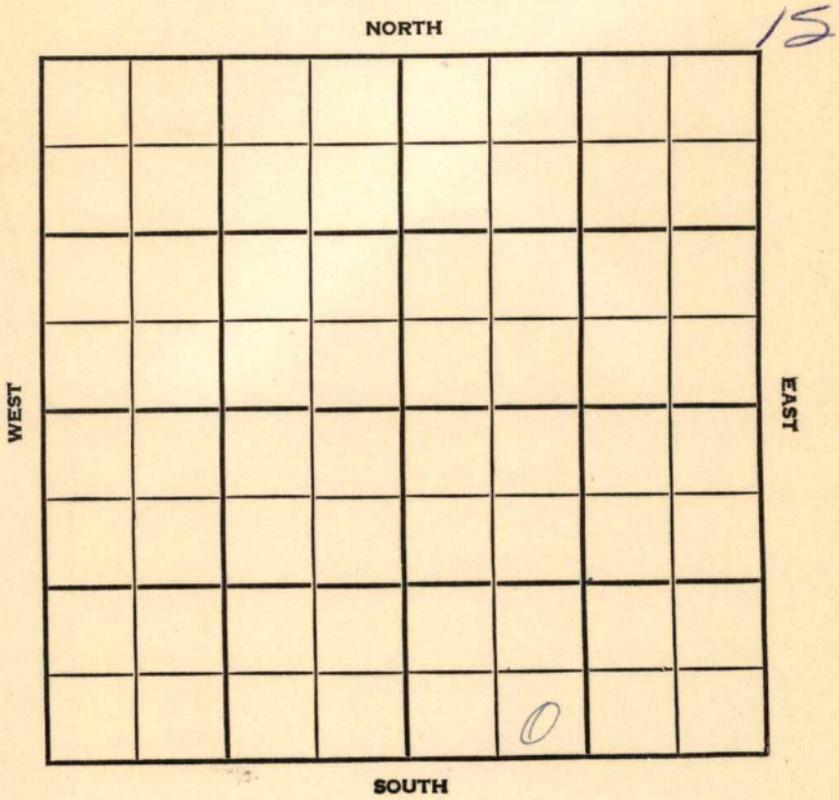

County Sumner Elev. 1110
 Sec. 1 Twp. 34 Rgs. 2 E
 Company McNeish & Gralapp
 Farm Name Gueda Springs Block 10 No. 1

TOPS	DEPTH	LOG	DATUM	Loc. in Sec.
Anh.				SE SW SE
Tp. <u>Stall</u>	<u>2287</u>	<u>2288</u>		
H. <u>Lay</u>		<u>2695</u>		
Tr.				
Dg.				
Bl.				
L.				Geol.
K.C.		<u>2866</u>		Contr.
B.K.C. <u>OSW</u>		<u>3072</u>		<u>Watson</u>
Ce.				Pool
C.		<u>3402</u>		<u>Padgett</u>
M.				
M.				
K.				
Mz.				
Mo.				
V.				
S.				
S.				
A.				
R.				
PE.				
G.				
T.D.	<u>3427</u>			

ABANDONED
 DEC 20 '56
 o

Date Comm. 12-3-56
 DEC 12 '56 8578 102 2416 DEC 19 '56

D&A