

STATE CORPORATION COMMISSION OF KANSAS
OIL & GAS CONSERVATION DIVISION

WELL COMPLETION OR RECOMPLETION FORM
ACO-1 WELL HISTORY

DESCRIPTION OF WELL AND LEASE

Operator: License # 6880
Name Summer Sun Gas
Address 406 S. School
City/State/Zip Sedan, Kansas 67361

Purchaser N/A

Operator Contact Person Gary D. Cude
Phone 316-725-3111

Contractor: License # 6282
Name Walt Darnall

Wellsite Geologist
Phone

Designate Type of Completion

New Well Re-Entry Workover

Oil SWD Temp Abd
 Gas Inj Delayed Comp.
 Dry Other (Core, Water Supply etc.)

If OWWO: old well info as follows:

Operator
Well Name
Comp. Date Old Total Depth

WELL HISTORY

Drilling Method:

Mud Rotary Air Rotary Cable

11-4-84 11-6-84 12-15-84
Spud Date Date Reached TD Completion Date

1648
Total Depth PBDT

Amount of Surface Pipe Set and Cemented at 80 feet
Multiple Stage Cementing Collar Used? Yes No

If alternate 2 completion, cement circulated
from 1638 feet depth to 61.2 w/ 225 SX cmt

API NO. 15-019-24771
County Chautauqua
NW SE SE Sec. 2 Twp. 34 Rge. 11 East West

1155 Ft North from Southeast Corner of Section
1073 Ft West from Southeast Corner of Section
(Note: Locate well in section plat below)


Lease Name Cude Well # 10

Field Name Sedan-Peru

Producing Formation Mississippi

Elevation: Ground 807 KB

Section Plat

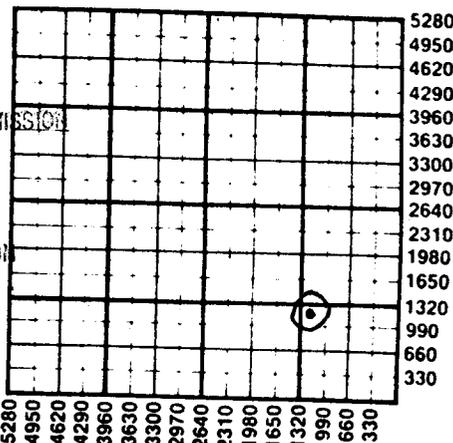

RECEIVED
STATE CORPORATION COMMISSION

JAN 02 1985

CONSERVATION DIVISION
Wichita, Kansas

WATER SUPPLY INFORMATION

Disposition of Produced Water: Disposal Repressuring
Docket # CD-118212 (C-21524)

Questions on this portion of the ACO-1 call:
Water Resources Board (913) 296-3717

Source of Water:
Division of Water Resources Permit #

Groundwater Ft North from Southeast Corner (Well) Ft West from Southeast Corner of Sec Twp Rge East West

Surface Water Ft North from Southeast Corner (Stream, pond etc) Ft West from Southeast Corner Sec Twp Rge East West

Other (explain) (purchased from city, R.W.D. #)

INSTRUCTIONS: This form shall be completed in duplicate and filed with the Kansas Corporation Commission, 200 Colorado Derby Building, Wichita, Kansas 67202, within 90 days after completion or recompletion of any well. Rule 82-3-130 and 82-3-107 apply.

Information on side two of this form will be held confidential for a period of 12 months if requested in writing and submitted with the form. See rule 82-3-107 for confidentiality in excess of 12 months. One copy of all wireline logs and drillers time log shall be attached with this form. Submit CP-4 form with all plugged wells. Submit CP-111 form with all temporary wells.

SIDE TWO

Operator Name Summer Sun Gas Lease Name Cude Well # 10

Sec. 2 Twp. 34 Rge. 11 East West County Chautauqua

WELL LOG

INSTRUCTIONS: Show important tops and base of formations penetrated. Detail all cores. Report all drill stem tests giving interval tested, time tool open and closed, flowing and shut-in pressures, whether shut-in pressure reached static level, hydrostatic pressures, bottom hole temperature, fluid recovery, and flow rates if gas to surface during test. Attach extra sheet if more space is needed. Attach copy of log.

Drill Stem Tests Taken Yes No
 Samples Sent to Geological Survey Yes No
 Cores Taken Yes No

Formation Description
 Log Sample

Name	Top	Bottom
Peru-wayside	1002	1016
Altamont	1058	1094
Pawnee	1189	1212
Oswego	1267	1324
Mississippi	1633	1648

CASING RECORD <input checked="" type="checkbox"/> New <input type="checkbox"/> Used							
Report all strings set-conductor, surface, intermediate, production, etc.							
Purpose of String	Size Hole Drilled	Size Casing Set (in O.D.)	Weight Lbs/Ft.	Setting Depth	Type of Cement	#Sacks Used	Type and Percent Additives
.....
surface	11	7.5/8	26	80	portland	35
production	6 3/4	4.1/2	9.1/2	1638	portland	225
PERFORATION RECORD				Acid, Fracture, Shot, Cement Squeeze Record			
Shots Per Foot	Specify Footage of Each Interval Perforated			(Amount and Kind of Material Used)			Depth
.....
.....
.....
.....
TUBING RECORD				Liner Run	<input type="checkbox"/> Yes <input type="checkbox"/> No		
Size	Set At	Packer at					
2 3/8	1635						