

KANSAS


Sumner

FORM 51 25M 3-49 PETROL

Section 12 Township 34 Range 2-E

Well No. #9 Clifton

Company Wakefield & Kanotex

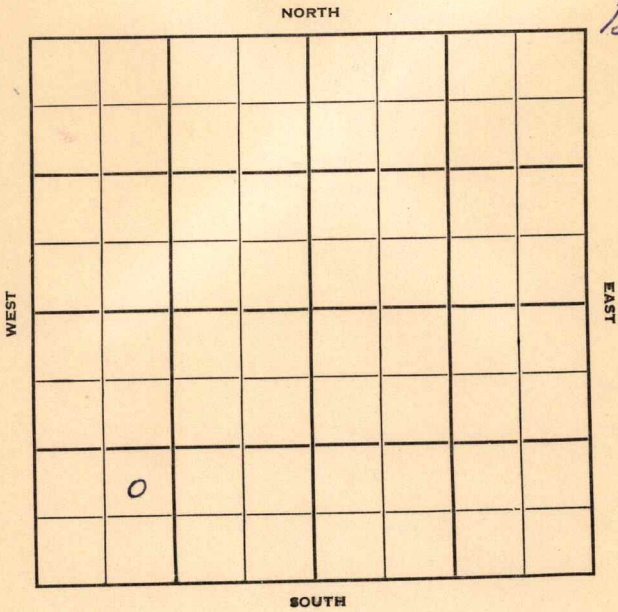

Summer

KANSAS



Sec. 12 Twp. 34 R. 2E

Well No. #9 Clifton Farm

Wakefield & Kanotex Company

Contractor

Padgett Pool


Ft. from N. Line

990' Ft. from S. Line

Ft. from E. Line

990' Ft. from W. Line

NE SW SW

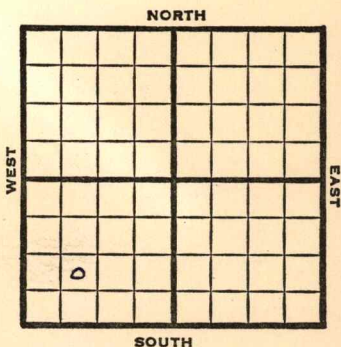

1950

Elev 1138'

REPORT

4/5

RUR

5/3

TD 2336'

10"@ 82'

8"@ 2220'

Layton 2227'

35 BOPD

Comp

COMPLETED

Map No. _____ Sec. 12 Twp. 34 R. 2EWell No. 9 CliftonWakefield & Kanotex Company_____
Contractor

NE SW SW

SECTION PLAT

FIRST REPORT

0

_____ Ft. from N. Line

990 Ft. from S. Line

_____ Ft. from E. Line

990 Ft. from W. Line

Sumner County

Location _____

Rig up _____

Drilling and Remarks:

R U R

RECORD

Cased _____ in., _____ ft.

Sand _____

Gas _____

Oil _____

Total Depth _____

PRODUCTION

1st 24 hrs. Nat. _____

1st 24 hrs. after shot _____

Gas _____ Cu. Ft.

Dry Hole _____

Abandoned _____

Date

APR 5

19

1950

J. E. TYRA

Scout

Kansas

Padgett Pool

Map No. _____ Sec. 12 Twp. 34 R. 2EWell No. 9 CliftonWakefield & Kanotex Company

Contractor

NE SW SW

E1.1138
SECTION PLAT

_____ Ft. from N. Line

990 Ft. from S. Line

_____ Ft. from E. Line

990 Ft. from W. Line

Sumner County

Location _____

Rig up _____

Drilling and Remarks:

10" @ 82
8" @ 2220
Layton 2227
35 BOPD

RECORD

Cased _____ in., _____ ft.

Sand _____

Gas _____

Oil _____

Total Depth 2336

PRODUCTION

1st 24 hrs. Nat. _____

1st 24 hrs. after shot _____

Gas _____ Cu. Ft.

Dry Hole _____

Abandoned _____

Date

MAY 3

1950

J. E. TYRA

19

Scout