


Section 12 Township 34 Range 2E

Well No. 1 Nugen

Company Time Petroleum

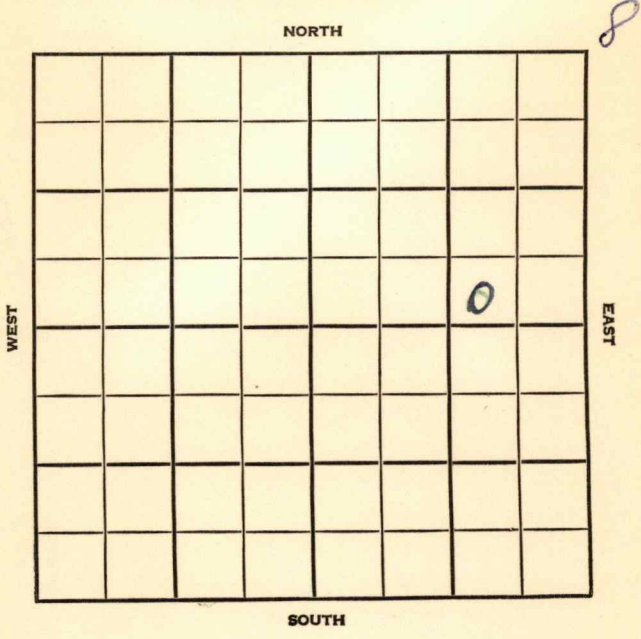

Sumner

KANSAS

SEC. 12	TWP. 34	R. 2E
------------	------------	----------

WELL NO. I Nugen FARM

COMPANY Time Petroleum

CONTRACTOR


Padgett

_____ Ft. from N. Line

_____ Ft. from S. Line

_____ Ft. from E. Line

_____ Ft. from W. Line

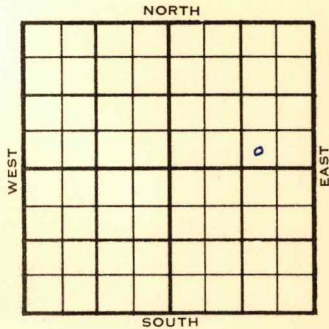

SW SE NE

~~6/29~~
1955

ELEVATION 1148' REPORT

6/29

Setting surface

8/10

8 5/8" @94 DST 3376-86 open 2 hr. Rec. 25' mud SSO 270/30" DST: 3391-98, op. 1 hr. Rec. 50' muddy oil 975# 5 1/2" @ 3393 CO to 3398 frac S/10 boph P/25 bop Comp.

Bl. Bart 3375 2227

C. Chert 3392 2244

TD: 3398

COMPLETED

County Summer Elev. _____
 Sec. 12 Twp. 34 Rgs. 2E
 Company Time Petroleum
 Farm Name Nugen No. 1

TOPS	DEPTH	LOG	DATUM
Anh.			
Tp.			
H.			
Tr.			
Dg.			
B.L.			
L.			
K.C.			
B.K.C.			
Ce.			
C.			
M.			
M.			
K.			
Mz.			
Mq.			
V.			
S.			
S.			
A.			
R.			
Pf.			
G.			
T.D.			

Loc. in Sec. SW SE NE
 Geol. _____
 Contr. _____
 Pool Padgett
 FIRST REPORT
 JUN 29 '55

Date Comm. setting surface

Co.
Lse.
No.
Sec.
T.
R.

County Sumner Elev. 1148
 Sec. 12 Twp. 34 Rge. 2E
 Company Time Petroleum
 FarmName Nugen No. 1

TOPS	DEPTH	LOG	DATUM	Loc. in Sec.																														
Anh.				SW SE NE																														
Tp.																																		
H.																																		
Tr.																																		
Dg.																																		
Bl. <u>Bant</u>	<u>3375</u>		<u>2227</u>																															
L.				Geol.																														
K.C.				Contr.																														
B.K.C.																																		
Ce.																																		
C. <u>Chert</u>	<u>3392</u>		<u>2244</u>																															
M.				Pool																														
M.				<u>Padgett</u>																														
K.				<table border="1"> <tr><td></td><td></td><td></td></tr> <tr><td></td><td></td><td></td></tr> <tr><td></td><td></td><td></td></tr> <tr><td></td><td></td><td></td></tr> <tr><td></td><td></td><td></td></tr> <tr><td></td><td></td><td></td></tr> <tr><td></td><td></td><td></td></tr> <tr><td></td><td></td><td></td></tr> <tr><td></td><td></td><td></td></tr> <tr><td></td><td></td><td></td></tr> </table>																														
Mz.																																		
Mq.																																		
V.																																		
S.																																		
S.																																		
A.																																		
R.																																		
PE.																																		
G.																																		
T.D.	<u>3398</u>			COMPLETE																														

Date Comm. AUG 10 1955
8 5/8" @ 94 DST 3376-86 open 2 hr.
Rec. 25' mud SSO 270/30" DST 3391-98
open 1 hr. Rec. 50' muddy oil 975#
5 1/2" @ 3393 CO to 3398 frac
S/ 10 boph B/ 25 bophd Comp.

Co.
Lse.
No.
Sec.
T.
R.