


KANSAS

Section 12 Township 34 Range 2 E

Well No. # 14 Clifton

Company Wakefield & Kanotex

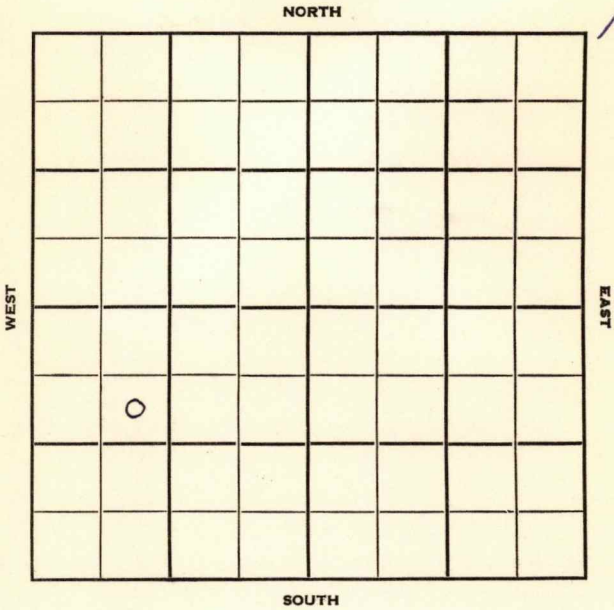

Sumner

KANSAS

Sec. 12 Twp. 34 R. 2 E

Well No. # 14 Clifton Farm

Wakefield & Kanotex Company

Wakefield Contractor


990 Ft. from N. Line

Ft. from S. Line

Ft. from E. Line

990 Ft. from W. Line

SE NW SW

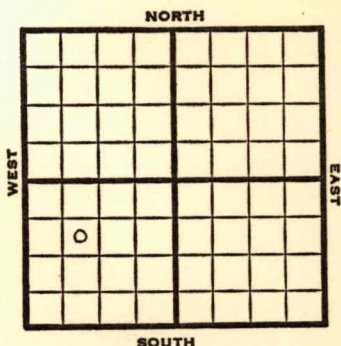

1951

Elev. 1138' REPORT

4/18

Spud 4-12-51
10" @ 80
Dr1g. 827'

5/9

Spud 4-12-51
D&A TD 2252
10" @ 60'
Itan 2225'
7"@ 2229
Stal. 2237
TD 2252
D&A

ABANDONED

County **Sumner** State **Kansas**

Sec. 12 (Blk. 34 (Sur. 2E Map No.

Operator Wakefield & Kanotex

Well No. 14 Farm Clifton

[illegible]

FIRST REPORT

990 Ft. From N Line SW

990 Ft. From W Line Quarter

1st. Report APR 18 1951

Completion

Remarks _____

Wakefield - Contr.

Spudding Date 4-12-51

Drlg. Data

10" @ 80 drlg. 827

County Sumner State KansasSec. 12 (Blk.
Twp.) 34 (Sur.
Rge.) 2E Map No.Operator Wakefield & KanotexWell No. 14 Farm CliftonElev. 1138 Location SE NW SW990 Ft. From N Line SW990 Ft. From W Line Quarter1st. ReportCompletion MAY 9 1951RemarksWakefield - Contr.Spudding Date 4-12-51Drlg. Data D & A TD 225210" @ 80 Itan 2225 7" @ 2229Stal. 2237 TD 2252D & A

J. E. TYRA