

Summer


DX 78-1

KANSAS

Section 12 Township 34 Range 2E

Well No. #1 Nutt

Company Time Petroleum

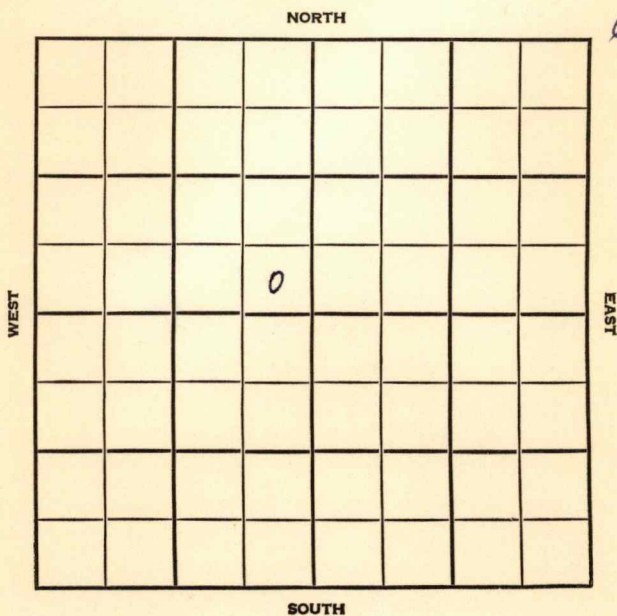

Sumner

KANSAS

SEC.	TWP.	R.
12	34	2 E

WELL NO.

1 Nutt

FARM

COMPANY

Time Petroleum

CONTRACTOR

Kirkpatrick
Padgett Pool


_____ Ft. from N. Line

330 _____ Ft. from S. Line

330 _____ Ft. from E. Line

_____ Ft. from W. Line

SE SE NW

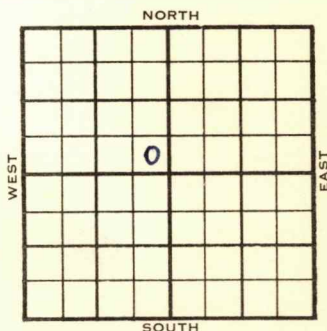

1955

ELEVATION

REPORT

3/9

Spud 2-28-55
8" @ 90
Brlg. 2800'

County Sumner State Kansas
 Sec. 12 (Blk. 34 (Sur. 2E Map No.
 (Twp.) (Rge.)
 Operator Time Petroleum
 Well No. 1 Farm Nutt
 Elev. Location SE SE NW

0

FIRST REPORT

330 Ft. From S Line NW
330 Ft. From E Line Quarter
 1st. Report MAR 9 1955

Completion

Remarks

Kirkpatrick - Contr.

Spudding Date 2-28-55

Drlg. Data

Padgett Pool

8" @ 90 drlg. 2800

FABEN GILSTRAP