

DX 78-1 **O.W.W.O.**


Summer

KANSAS

Section 12 Township 34 Range 2 E

Well No. #1 Wykoff

Company H + M Drlg.
~~Susmie~~

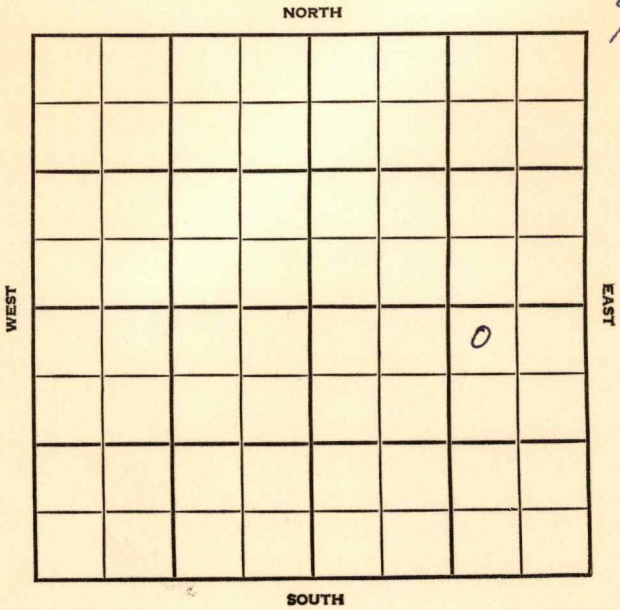

Sumner

O.W.W.O.

KANSAS

SEC. 12	TWP. 34	R. 2E
------------	------------	----------


WELL NO. #1 Wykoff FARM

COMPANY ~~M. & M. Dalg.~~
Susmie

CONTRACTOR Kirkpatrick

Padgett

_____ Ft. from N. Line
 _____ Ft. from S. Line
 _____ Ft. from E. Line
 _____ Ft. from W. Line

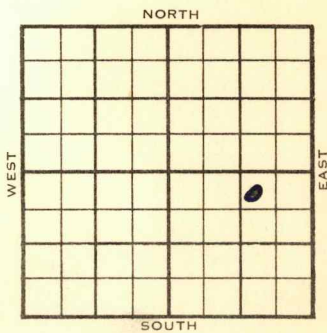

NW NE SE

1955 ELEVATION 1158' REPORT **FIRST REPORT**

8/10 Surface set
 8-24 Comm. 8-14-55
 8" @ 85/75
 DST 3410-32, open 1 hr. Rec. 1320' gas
 32' so & gcm 30' ho & gcm 430/20"
 DST 3434-48, open 1/2 hr., Rec. 30' gc &
 vsocm, 180' sgc & ocmsw, 900/30",
 D & A
 H. Stal Lm 2273, 1115
 Tr. Stal sd 2303, 1145
 Dg. Layton 2737, 1579, K.C. 2902, 1744,
 B.K.C. Oswego, 3101, 1943,
 C. Cattleman, 3305, 2147, M. 3416, 2258
 T.D. 3448

ABANDONED

1955
 11/16 OTD 3448'
 CO to 3448' 5" @ 3448
 Stal 2303', Layton 2737', KC 2902'
 Oswego 3101', Cattleman 3305',
 Miss 3416'

O.W.W.O.

1956
 1-11 S/ 10 bopd, 12/ 3425-28,
 Comp. 10 bopd, 40 BW,
 TD 3448'

COMPLETED

County Sumner Elev. _____
 Sec. 12 Twp. 34 Rge. 2E
 Company Susmio
 FarmName Wykoff No. 1

TOPS	DEPTH	LOG	DATUM
Anh.			
TP.			
H.			
Tr.			
Dg.			
Bl.			
L.			
K.C.			
B.K.C.			
Ce.			
C.			
M.			
M.			
K.			
Mz.			
Me.			
V.			
S.			
S.			
A.			
R.			
PE.			
G.			
TD.			

Loc. in Sec. NW NE SE
 Geol. _____
 Contr. Kirkpatrick
 Pool Padgett

FIRST REPORT
 AUG 10 '85

Date Comm. surface set

Co.
Lse.
No.
Sec.
T.
R.

County Sumner Elev. 1158
 Sec. 12 Twp. 34 Rge. 2E
 Company Susmio
 Farm Name Wykoff No. 1

TOPS	DEPTH	LOG	DATUM
Anh.			
Tr.			
H. <u>Stal Lm</u>	<u>2273</u>		<u>1115</u>
Tr. <u>" sd</u>	<u>2303</u>		<u>1145</u>
Dg. <u>Layton</u>	<u>2737</u>		<u>1579</u>
Bl.			
L.			
K.C.	<u>2902</u>		<u>1744</u>
B.K.C. <u>Conroy</u>	<u>3101</u>		<u>1948</u>
Ce.			
C. <u>Cottleman</u>	<u>3305</u>		<u>2147</u>
M.			
M.	<u>3416</u>		<u>2258</u>
K.			
Mz.			
Ma.			
V.			
S.			
S.			
A.			
R.			
Pe.			
G.			
T.D.	<u>3448</u>		

Loc. in Sec. _____
 NW NE SE
 Geol. _____
 Contr. _____
 Kirkpatrick
 Pool
 Padgett



Date Comm. 8-14-55 AUG 24 1955

8" @ 85/75 DST 3410-32 open 1 hr.
 Rec. 1320' gas 32' so & gcm 30' ho &
 gcm 430/20" DST 3434-48 open 1/2 hr.
 Rec. 30' gc & vsocm 180' sgc & ocmsw
 900/30"

D & A

Co.
 Lse.
 No.
 Sec.
 T.
 R.

O.W.W.O.

O.W.O.

FORM 513 REV. SUNRAY

County Sumner Elev. 1158
 Sec. 12 Twp. 34 Rge. 2E
 Company H & M Drlg.
 FarmName Wykoff No. 1

TOPS	DEPTH	LOG	DATUM	Loc. in Sec.
Anh.				NW NE SE
TP.				
H. <u>stal.</u>	<u>2303</u>			
Tr. <u>Layton</u>	<u>2737</u>			
Dg.				
Bl.				
L.				Geol.
K.C.	<u>2902</u>			
B.K.C.				Contr.
Ce. <u>Oswego</u>	<u>3101</u>			
C.				
M. <u>Cattlemen</u>	<u>3305</u>			Pool
M. <u>iss</u>	<u>3416</u>			
K.				
Mz.				
Me.				
V.				
S.				
S.				
A.				
R.				
PC.				
G.				
TD.	<u>3448</u>			

FIRST REPORT

NOV 15 1955

Date Comm. OO to 3448 5" @ 3448

Co.
Lse.
No.
Sec.
T.
R.

OWWO

County Sumner Elev. 1158
 Sec. 12 Twp. 34 Rge. 2E
 Company H & M Drlg.
 Farm Name Wykoff No. 1

TOPS	DEPTH	LOG	DATUM
Anh.			
TP.			
H. <u>Stal</u>	<u>2303</u>		<u>1145</u>
Tr. <u>Langston</u>	<u>2737</u>		<u>1579</u>
Dg.			
Bl.			
L.			
K.C.	<u>2902</u>		<u>1744</u>
B.K.C.			
Ce. <u>Barnege</u>	<u>3101</u>		<u>1943</u>
C.			
M. <u>Cattleman</u>	<u>3305</u>		<u>2147</u>
M. <u>res</u>	<u>3416</u>		<u>2258</u>
K.			
Mz.			
Mq.			
V.			
S.			
S.			
A.			
R.			
PE.			
G.			
T.D.	<u>3448</u>		

Loc. in Sec. NW NE SE

Geol. _____

Contr. _____

Pool _____

COMPLETE		

Date Comm. JAN 1 1 1956

CO to 3448 5" @ 3448 S/ 10 bopd

12/ 3425-28 Comp. 10 bopd 40 bw

Co.

Lse.

No.

Sec.

T.

R.