SIDE ONE

STATE CORPORATION COMMISSION OF KANSAS
OIL & GAS CONSERVATION DIVISION
WELL COMPLETION OR RECOMPLETION FORM
ACO-1 WELL HISTORY
DESCRIPTION OF WELL AND LEASE

Operator: License # 8054
Name Mallard Drilling Corp.
Address P. O. Box 1527
City/State/Zip Shreveport, LA 71165

Purchaser Koch Oil Co.
Wichita, KS 67202

Operator Contact Person Tom Carmody
Phone 318 869-2073

Contractor: License # 6792
Name Caney Valley Drilling

Wellsite Geologist Bob Hopkins
Phone 316 725-5602

Designate Type of Completion
x New Well ___ Re-Entry ___ Workover

x Oil ___ SWD ___ Temp Abd
___ Gas ___ Inj ___ Delayed Comp.
___ Dry ___ Other (Core, Water Supply etc.)

If OWWO: old well info as follows:
Operator
Well Name
Comp. Date Old Total Depth

WELL HISTORY

Drilling Method:
x Mud Rotary ___ Air Rotary ___ Cable

4-16-86 | 4-21-86 | 5-7-86
Spud Date | Date Reached TD | Completion Date

910' | --
Total Depth | PBTD

Amount of Surface Pipe Set and Cemented at 40 feet
Multiple Stage Cementing Collar Used? ___ Yes x No
If yes, show depth set feet
If alternate 2 completion, cement circulated
from 904' feet depth to surface w/ 100 SX cmt
Cement Company Name Consolidated
Invoice # 62078

API NO. 15- 125-28,278

County Montgomery

NW NW SW Sec 2 Twp 34 Rge 13 x East ___ West

2140 Ft North from Southeast Corner of Section
5080 Ft West from Southeast Corner of Section
(Note: Locate well in section plat below)


Lease Name Ball Well # 64

Field Name Wayside-Havana

Producing Formation Weiser Sand

Elevation: Ground 768 KB --

Section Plat

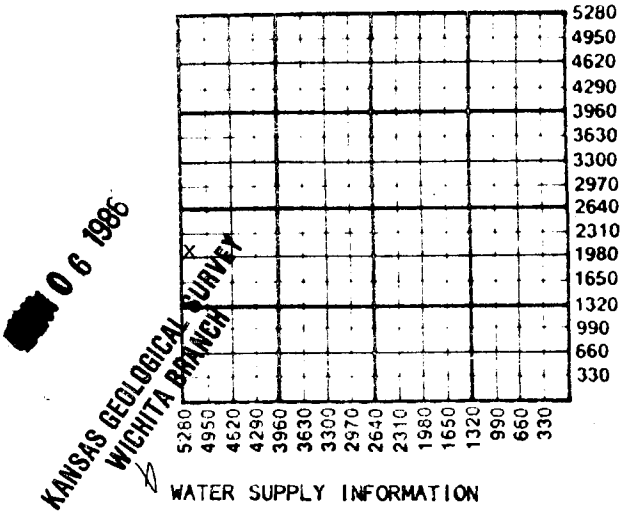

0 6 1986
KANSAS GEOLOGICAL SURVEY
WICHITA BRANCH

WATER SUPPLY INFORMATION

Disposition of Produced Water: x Disposal
Docket # D-20121 ___ Repressuring

Questions on this portion of the ACO-1 call:
Water Resources Board (913) 296-3717

Source of Water:
Division of Water Resources Permit #

___ Groundwater Ft North from Southeast Corner
(Well) Ft West from Southeast Corner of
Sec Twp Rge ___ East ___ West

x Surface Water 2100 Ft North from Southeast Corner
(Stream, pond etc) 5100 Ft West from Southeast Corner
Sec 2 Twp 34 Rge 13 x East ___ West

___ Other (explain)
(purchased from city, R.W.D. #)

INSTRUCTIONS: This form shall be completed in duplicate and filed with the Kansas Corporation Commission, 200 Colorado Derby Building, Wichita, Kansas 67202, within 90 days after completion or recompletion of any well. Rule 82-3-130 and 82-3-107 apply.
Information on side two of this form will be held confidential for a period of 12 months if requested in writing and submitted with the form. See rule 82-3-107 for confidentiality in excess of 12 months.
One copy of all wireline logs and drillers time log shall be attached with this form. Submit CP-4 form with all plugged wells. Submit CP-111 form with all temporarily abandoned wells.