

STATE CORPORATION COMMISSION OF KANSAS
OIL & GAS CONSERVATION DIVISION

WELL COMPLETION OR RECOMPLETION FORM
ACO-1 WELL HISTORY

DESCRIPTION OF WELL AND LEASE

Operator: License # 8054
Name .. Mallard Drilling Corp.
Address .. P. O. Box 1527
City/State/Zip .. Shreveport, LA .. 71165

Purchaser .. Koch Oil Co.
Wichita, KS 67202

Operator Contact Person .. Tom Carmody
Phone .. 318 869-2073

Contractor: License # .. 6792
Name .. Caney Valley Drilling, Inc.

Wellsite Geologist .. Bob Hopkins
Phone .. 316 725-5602

Designate Type of Completion

☒ New Well ☐ Re-Entry ☐ Workover

☒ Oil ☐ SWD ☐ Temp Abd
☐ Gas ☐ Inj ☐ Delayed Comp.
☐ Dry ☐ Other (Core, Water Supply etc.)

If ONWO: old well info as follows:

Operator ..
Well Name ..
Comp. Date .. Old Total Depth ..

WELL HISTORY

Drilling Method:

☒ Mud Rotary ☐ Air Rotary ☐ Cable

4-7-86 4-10-86 5-8-86
Spud Date Date Reached TD Completion Date
915' ..
Total Depth PBTD

Amount of Surface Pipe Set and Cemented at 36 feet
Multiple Stage Cementing Collar Used? ☐ Yes ☒ No
If yes, show depth set .. feet
If alternate 2 completion, cement circulated
from 906 feet depth to surface w/. 100 SX cmt
Cement Co.: Consolidated - Invoice # 65451

API NO. 15-125-28.279

County .. Montgomery

SW NW SW Sec 2 Twp 34 Rge 13 ☒ East
..... West

1650 Ft North from Southeast Corner of Section
4950 Ft West from Southeast Corner of Section

(Note: Locate well in section plat below)


Lease Name .. Ball Well # 65

Field Name .. Wayside - Havana

Producing Formation .. Weiser Sand

Elevation: Ground .. 766' KB ..

Section Plat

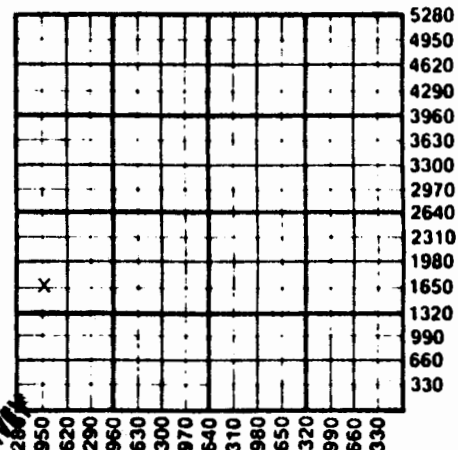

WATER SUPPLY INFORMATION

Disposition of Produced Water: ☒ Disposal
D-20.121 ☐ Repressuring

Questions on this portion of the ACO-1 call:

Water Resources Board (913) 296-3717

Source of Water:

Division of Water Resources Permit # ..

☐ Groundwater .. Ft North from Southeast Corner
(Well) .. Ft West from Southeast Corner of
Sec Twp Rge ☐ East ☐ West

☒ Surface Water .. 500 Ft North from Southeast Corner
(Stream, pond etc) 4500 Ft West from Southeast Corner
Sec 2 Twp 34 Rge 13 ☒ East ☐ West

☐ Other (explain) ..
(purchased from city, R.W.D. #)

INSTRUCTIONS: This form shall be completed in duplicate and filed with the Kansas Corporation Commission, 200 Colorado Derby Building, Wichita, Kansas 67202, within 90 days after completion or recompletion of any well. Rule 82-3-130 and 82-3-107 apply.

Information on side two of this form will be held confidential for a period of 12 months if requested in writing and submitted with the form. See rule 82-3-107 for confidentiality in excess of 12 months.

One copy of all wireline logs and drillers time log shall be attached with this form. Submit CP-4 form with all plugged wells. Submit CP-111 form with all temporarily abandoned wells.