

STATE CORPORATION COMMISSION OF KANSAS
OIL & GAS CONSERVATION DIVISION
WELL COMPLETION OR RECOMPLETION FORM
ACO-1 WELL HISTORY
DESCRIPTION OF WELL AND LEASE

Operator: License # 8054
Name Mallard Drilling Corp.
Address P. O. Box 1527
..... Shreveport, LA 71165
City/State/Zip

Purchaser..... Koch Oil Company.....
..... Wichita, Ks.....

Operator Contact Person ..Tom Garmony.....
Phone ..318-869-2073.....

Contractor: License # 6792.....
Name ...Caney Valley Drilling Corp.....

Wellsite Geologist..Robert T. Hopkins.....
Phone...316-725-5602.....

Designate Type of Completion

☒ New Well ☐ Re-Entry ☐ Workover

☒ Oil ☐ SWD ☐ Temp Abd
☐ Gas ☐ Inj ☐ Delayed Comp.
☐ Dry ☐ Other (Core, Water Supply etc.)

If OWWO: old well info as follows:

Operator

Well Name

Comp. DateOld Total Depth.....

WELL HISTORY

Drilling Method:

☒ Mud Rotary ☐ Air Rotary ☐ Cable

..4-21-86... ..4-24-86... ..5-7-86.....
Spud Date Date Reached TD Completion Date

.....910'.....
Total Depth PBTD

Amount of Surface Pipe Set and Cemented at 32...feet
Multiple Stage Cementing Collar Used? ☐ Yes ☒ No

If yes, show depth set.....feet

If alternate 2 completion, cement circulated
from 905.....feet depth to 0.....w/. 100 SX cmt

Cement Company NameConsolidated.....
Invoice #62083.....

API NO. 15-....125-28324.....

County.....Montgomery.....

..SE. SW. SW. Sec.2... Twp.34...Rge.13...
.....West

330..... Ft North from Southeast Corner of Section
4445..... Ft West from Southeast Corner of Section
(Note: Locate well in section plat below)


Lease Name.....Ball.....Well #..67.....

Field Name.....Wayside-Havana.....

Producing Formation...Weiser Sand.....

Elevation: Ground....764.....KB.....

Section Plat

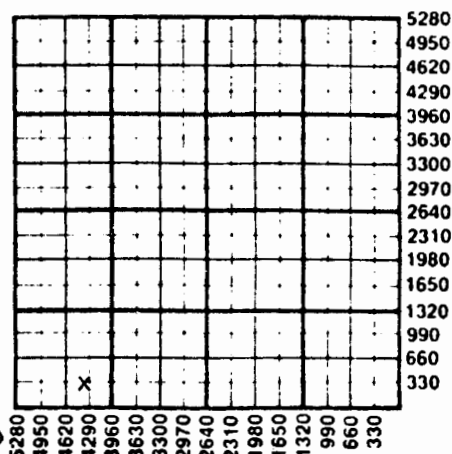

WATER SUPPLY INFORMATION

Disposition of Produced Water:

Docket #

☒ Disposal

☐ Repressuring

Questions on this portion of the ACO-1 call:

Water Resources Board (913) 296-3717

Source of Water:

Division of Water Resources Permit #.....

Groundwater.....Ft North from Southeast Corner
(Well)Ft West from Southeast Corner of
Sec Twp Rge East West

☒ Surface Water.....300.....Ft North from Southeast Corner
(Stream, pond etc.).....4300.....Ft West from Southeast Corner
Sec 2 Twp 34 Rge 13 ☒ East West

Other (explain).....
(purchased from city, R.W.D. #)

INSTRUCTIONS: This form shall be completed in triplicate and filed with the Kansas Corporation Commission, 200 Colorado Derby Building, Wichita, Kansas 67202, within 120 days of the spud date of any well. Rule 82-3-130, 82-3-107 and 82-3-106 apply.

Information on side two of this form will be held confidential for a period of 12 months if requested in writing and submitted with the form. See rule 82-3-107 for confidentiality in excess of 12 months.

One copy of all wireline logs and drillers time log shall be attached with this form. Submit CP-4 form with all plugged wells. Submit CP-111 form with all temporarily abandoned wells.