

KANSAS

FORM 51 25M 3-49 PETROL

Sumner

Section 14 Township 34 Range 2E

Well No. 3 Adsit

Company Wakefield & Kanotex

Misc.

NORTH

WEST

							0

EAST

SOUTH

Sumner

KANSAS



Sec. 14 Twp. 34 R. 2E

Well No. #3 Adsit Farm

Wakefield & Kanotex

Company

Miscellaneous (Wakefield, Cont.)

NORTH


330' Ft. from N. Line

 Ft. from S. Line

330' Ft. from E. Line

 Ft. from W. Line

NE/C

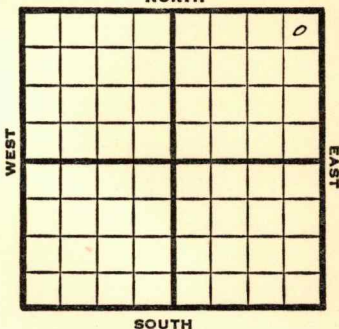

1949

Elev 1135'

REPORT

9/21 Surface Hole
9/28 SD
10/5 "
10/12 "
10/19 "
10/26 "
11/1 "
11/9 Location
Aband.

ABANDONED

Map No. _____ Sec. 14 Twp. 34 R. 2E

Well No. 3 Adsit

Wakefield & Kanotex Company

Wakefield Contractor

NE/C


FIRST REPORT
SECTION PLAT

330 Ft. from N. Line

Ft. from S. Line

330 Ft. from E. Line

Ft. from W. Line

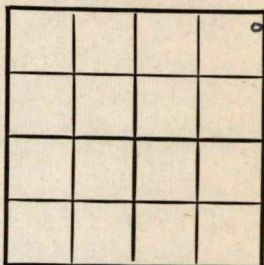

Sumner County

Location _____

Rig up _____

Drilling and Remarks:

surface hole

RECORD

Cased _____ in., _____ ft.

Sand _____

Gas _____

Oil _____

Total Depth _____

PRODUCTION

1st 24 hrs. Nat. _____

1st 24 hrs. after shot _____

Gas _____ Cu. Ft.

Dry Hole _____

Abandoned _____

Date

SEP 21 1949 19

S. J. LEWIS Scout

Kansas

Map No. _____ Sec. 14 Twp. 34 R. 2EWell No. 3 Adsit

Wakefield & Kanotex _____ Company

ABANDONED

Contractor

NE/C

E. 1/4 35
SECTION PLAT

			<u>0</u>

330 Ft. from N. Line

_____ Ft. from S. Line

330 Ft. from E. Line

_____ Ft. from W. Line

Summer County

Location ✓

Rig up _____

Drilling and Remarks:

RECORD

Cased _____ in., _____ ft.

Sand _____

Gas _____

Oil _____

Total Depth _____

PRODUCTION

1st 24 hrs. Nat. _____

1st 24 hrs. after shot _____

Gas _____ Cu. Ft.

Dry Hole _____

Abandoned _____

Date

NOV 9 1949 19

S. J. LEWIS

Scout