

KANSAS

Summer

Summer

KANSAS ✓

Sec. 14 Twp. 34 R. 2E

Section 14 Township 34 Range 2-E

Well No. #3 Adsit

Company Wakefield & Kanotex
Miscellaneous

Well No. #3 Adsit Farm _____

Wakefield & Kanotex Company _____

Miscellaneous (Wakefield, Contr.)



330' Ft. from N. Line

_____ Ft. from S. Line

330' Ft. from E. Line

_____ Ft. from W. Line

NE/C

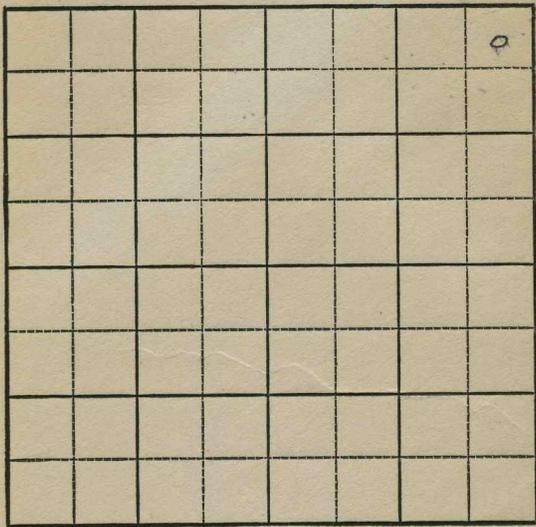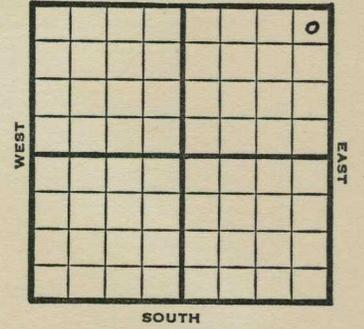

1949	REPORT
11/30	8" @ 79' Drlg. 1156'
12/7	KC 2886' Drlg 3121'
12/14	Miss 3397' TD 3400-5" @ 3399'
12/21	TD 3416 Miss 3392' 5" @ 3399' Pump 25 Oil Pot 40° Gr. Comp
	COMPLETED

Map No. _____ Sec. 14 Twp. 34 R. 2E

Well No. 3 Adsit


Wakefield & Kanotex Company

COMPLETE Contractor

NE/C

SECTION PLAT

330 Ft. from N. Line
Ft. from S. Line
330 Ft. from E. Line
Ft. from W. Line

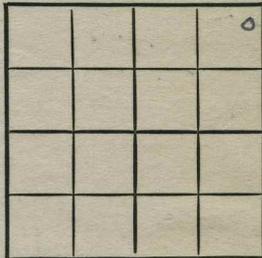

Sumner County

Location _____

Rig up _____

Drilling and Remarks:

RECORD

Cased _____ in., _____ ft.

Sand _____

Gas _____

Oil _____

Total Depth 2476

PRODUCTION

1st 24 hrs. Nat. _____

1st 24 hrs. after shot _____

Gas _____ Cu. Ft.

Dry Hole _____

Abandoned _____

Misc 392
5" C 8889
Prof 25 oil
40° Sw

Date

DEC 21 1949 19

S. J. LEWIS Scout

Map No. _____ Sec. 14 Twp. 34 R. 2E

Well No. 3 Adsit


Wakefield & Kanotex Company

Wakefield Contractor

NE/C

FIRST REPORT
SECTION PLAT

330 Ft. from N. Line
Ft. from S. Line
330 Ft. from E. Line
Ft. from W. Line

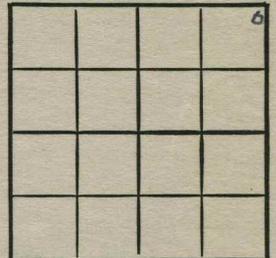

Sumner County

Location _____

Rig up _____

Drilling and Remarks:

RECORD

Cased _____ in., _____ ft.

Sand _____

Gas _____

Oil _____

Total Depth _____

PRODUCTION

1st 24 hrs. Nat. _____

1st 24 hrs. after shot _____

Gas _____ Cu. Ft.

Dry Hole _____

Abandoned _____

8" @ 79
drlg. 1156

Date

NOV 30 1949 19

S. J. LEWIS Scout