


KANSAS Sumner

Section 14 Township 34 Range 2E
 Well No. #3 Gravit *(Credit)*
 Company M B Armer

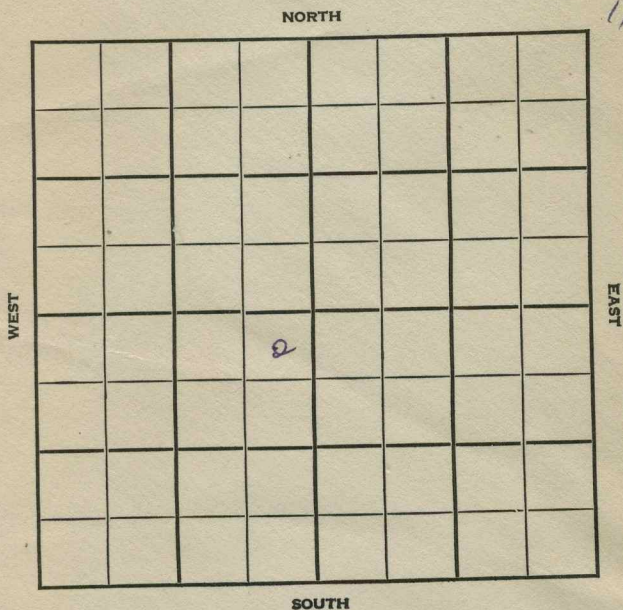

KANSAS

Sumner

Sec. 14 Twp. 34 R. 2E

Well No. #3 Gravit Farm
W. B. Armer Company

Miscellaneous


330' Ft. from N. Line

Ft. from S. Line

330' Ft. from E. Line

Ft. from W. Line

NE SW

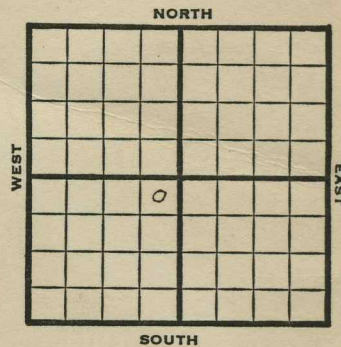

1948

REPORT

6/23 Location

6/29 "

7/8 "

7/14 "

7/21 "

7/28 "

8/4 "

8/11 "

8/18 "

8/25 "

9/1 Location

Aband.


ABANDONED

Sumner County Kansas State
 Map No. 1 Sec. 14 Twp. 34 R. 2E
 Well No. 3 Cravit
 M. B. Armer Company
~~ABANDONED~~ Contractor

NE SW

SECTION PLAT

330 Ft. from N. Line
 _____ Ft. from S. Line
330 Ft. from E. Line
 _____ Ft. from W. Line

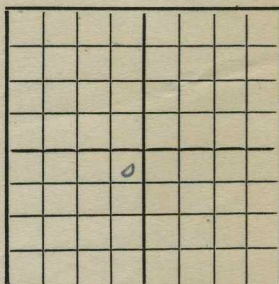

Miscellaneous

Remarks:

Loc

Date
 SEP 1 1948


Scout
 S. J. LEWIS

Map No. _____ Sec. 14 Twp. 34 R. 2E
 Well No. 3 Cravit
 M. B. Armer Company
 FIRST REPORT Contractor

NE SW

SECTION PLAT

330 Ft. from N. Line
 _____ Ft. from S. Line
330 Ft. from E. Line
 _____ Ft. from W. Line

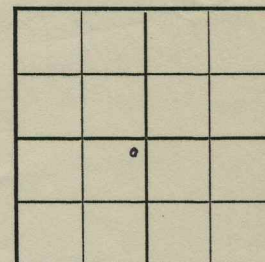

Sumner County

Location x

RECORD

Rig up _____

Drilling and Remarks:

Cased _____ in., _____ ft.
 Sand _____
 Gas _____
 Oil _____
 Total Depth _____

PRODUCTION

1st 24 hrs. Nat. _____
 1st 24 hrs. after shot _____
 Gas _____ Cu. Ft.
 Dry Hole _____
 Abandoned _____

Date

JUN 23 1948 19 S. J. LEWIS Scout