

KANSAS


Map No. Sec. 14 Twp. 34 R. 2 E

Well No. 1- Hendrix Farm

Harris & Hahn Company

NORTH

15

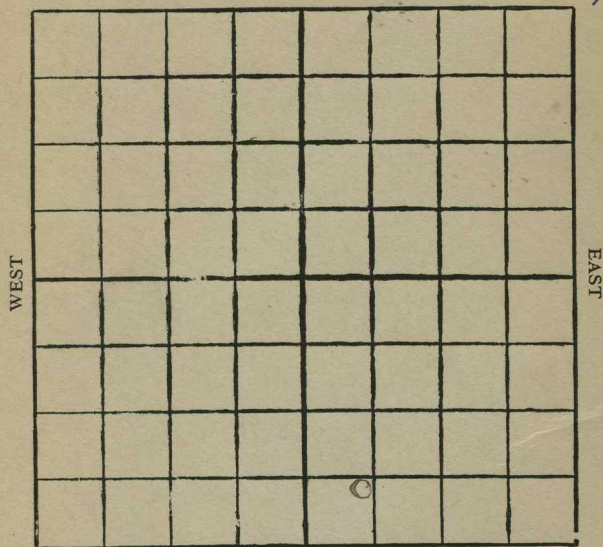

SOUTH

 Location
 Drilling Remarks

 Rig Up
 Drilling Remarks

RECORD

 Cased in. ft.
 Sand
 Gas
 Oil
 Total Depth

PRODUCTION

 1st 24 hrs. Nat.
 1st 24 hrs. after shot
 Gas cu. ft.
 Dry Hole
 Abandoned

KANSAS

Map No. Sec. 14 Twp. 34 R. 2 E

Well No. 1- Hendrix Farm

Harris & Hahn Company


NORTH

Ft. from N. Line

640 Ft. from S. Line

Ft. from E. Line

640 Ft. from W. Line

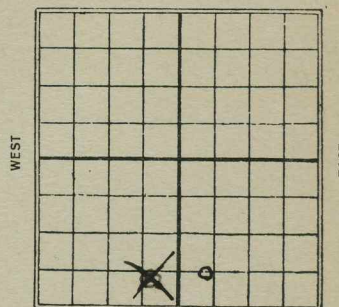

1928

Gas test

Date

REPORT

3/7	Location
3/14	Bldg rig
3/21	
3/28	Apud
4/4	
4/11	Drilg 805
4/18	" 1545
4/25	" 1977
5/2	" 2030
5/9	" 2590
5/16	" 2765
5/23	" 2985
5/31	Top Chat 3450 - drilg 3453 -
6/6	T.D. 3475 - Slut down
6/13	T.D. 3475 - straight ream 6"
6/20	T.D. 3507 - fishing tools -
6/27	No report
7/3	Drilg 3600
7/11	Top Wilcox 3772 T.D. 3777
	Shut in 230 bbls 24 hrs
7/18	Wilcox 3772-3783
	T.D. in sd. pumping 100 bbl

Map No. KANSAS Sec. 14 Twp. 34 R. 2EWell No. 1 HendrixHarris & Hahn Company

Contractor

SECTION PLAT

		0	

----- Ft. from N. Line

640 Ft. from S. Line

----- Ft. from E. Line

640 Ft. from W. Line**COMPLETED**

Location -----

Rig up -----

Drilling and Remarks:

Philcox Sand3772 & 3783Total depth in sand.Pumping 100 gals

RECORD

Cased ----- in., ----- ft.

Sand -----

Gas -----

Oil -----

Total Depth -----

PRODUCTION

1st 24 hrs. Nat. -----

1st 24 hrs. after shot -----

Gas ----- Cu. Ft.

Dry Hole -----

Abandoned -----

Date

JUL 18 1928

192

S. J. LEWIS

Scout

Map No. KANSAS Sec. 14 Twp. 34 R. 2EWell No. 1 HendrixHarris & Hahn Company

Contractor

SECTION PLAT

		0	

----- Ft. from N. Line

640 Ft. from S. Line

----- Ft. from E. Line

640 Ft. from W. Line**FIRST REPORTS**

Location -----

Rig up -----

Drilling and Remarks:

Gas test

RECORD

Cased ----- in., ----- ft.

Sand -----

Gas -----

Oil -----

Total Depth -----

PRODUCTION

1st 24 hrs. Nat. -----

1st 24 hrs. after shot -----

Gas ----- Cu. Ft.

Dry Hole -----

Abandoned -----

Date

MAR 7 1928

192

S. J. LEWIS

Scout