

Section 14 Township 34S Range 2E

Well No. #4 Adsit

Company Wakefield & Kanotex

Sec. 14 Twp. 34 R. 2-E

Well No. #4 Adsit Farm

Wakefield & Kanotex Company

Miscellaneous


990 Ft. from N. Line

_____ Ft. from S. Line


330 Ft. from E. Line

_____ Ft. from W. Line

SE NE NE

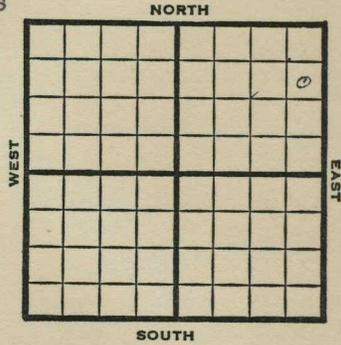

NORTH

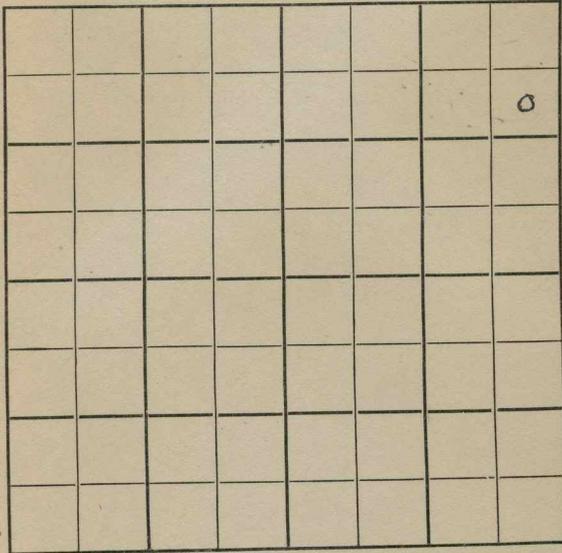

SOUTH

1949		Elev. 1140'	REPORT
10/5	8" @ 65		
	Drlg 2168'		
10/12	"		
10/19	Miss 3397'		
	5" @ 3397'		
	TD 3407'		
	700' oil		
10/26	TD 3407'		
11/2	TD 3407'		
	Miss 3397'		
	5" @ 3397'		
	Pump 20 Oil Pot		
	38° Gr.		
	Comp		

COMPLETED

Map No. _____ Sec. 14 Twp. 34 R. 2E

Well No. 4 Adsit

Wakefield & Kanotex Company

COMPLETE

Contractor

SE NE NE

E. 1140
SECTION PLAT

990 Ft. from N. Line

Ft. from S. Line

330 Ft. from E. Line

Ft. from W. Line

Sumner County

Location _____

Rig up _____

Drilling and Remarks:

Miss 3397

5" @ 3397

Pump 20 oil ft

382 ft

RECORD

Cased _____ in., _____ ft.

Sand _____

Gas _____

Oil _____

Total Depth *3427*

PRODUCTION

1st 24 hrs. Nat. _____

1st 24 hrs. after shot _____

Gas _____ Cu. Ft.

Dry Hole _____

Abandoned _____

Date

NOV 2 1949 19

S. J. LEWIS Scout

Map No. _____ Sec. 14 Twp. 34 R. 2E

Well No. 4 Adsit

Wakefield & Kanotex Company

Contractor

SE NE NE

FIRST REPORT
SECTION PLAT

990 Ft. from N. Line

Ft. from S. Line

330 Ft. from E. Line

Ft. from W. Line

Sumner County

Location _____

Rig up _____

Drilling and Remarks:

8" @ 65

drlg. 2168

RECORD

Cased _____ in., _____ ft.

Sand _____

Gas _____

Oil _____

Total Depth _____

PRODUCTION

1st 24 hrs. Nat. _____

1st 24 hrs. after shot _____

Gas _____ Cu. Ft.

Dry Hole _____

Abandoned _____

Date

OCT 5 1949 19

S. J. LEWIS Scout