


KANSAS
 Map No. _____ Sec. 14 Twp. 34 R. 2E
 Well No. 1 - Farnsb Farm _____
Harris & Hahn Company _____
Home Nat Gas NORTH

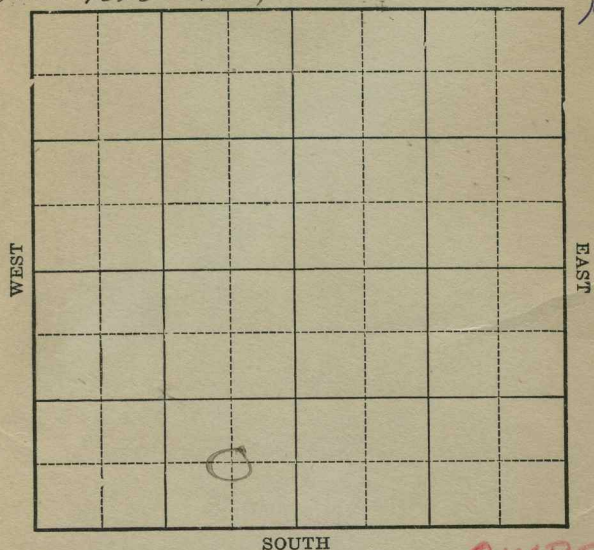

SOUTH

Location _____
 Drilling Remarks _____

Rig Up _____
 Drilling Remarks _____

RECORD


Cased _____ in. _____ ft.
 Sand _____
 Gas _____
 Oil _____
 Total Depth _____

PRODUCTION

1st 24 hrs. Nat. _____
 1st 24 hrs. after shot _____
 Gas _____ cu. ft.
 Dry Hole _____
 Abandoned _____

KANSAS
 Map No. _____ Sec. 14 Twp. 34 R. 2E
 Well No. 1 - Home Nat Gas Farm _____
Harris & Hahn Company _____

660 Ft. from N. Line
645 Ft. from S. Line
660 Ft. from E. Line
 _____ Ft. from W. Line

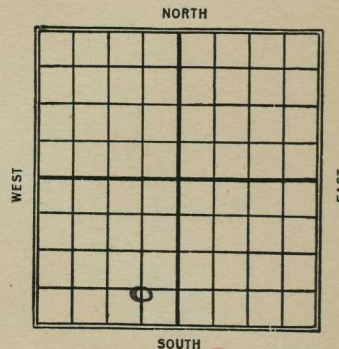

1927

OWDP

Date


REPORT

12/14 Rig
 12/21 Spud
 12/28 Drlg 415-
 1928
 1/4 Drlg 862
 1/11 " 1011
 1/18 " 2507
 1/25 T.D. 2507 - fighting care-
 1/31 T.D. 2570 - u.R. 8"
 2/15 T.D. 3000 - S.D.
 2/22 Top sand 3425 - 1 M gas-
 Rig burned down-
 2/29 Rigging up-
 3/7 Sand 3425-3433-T.D.
 9 M gas
 800# R.P.
 1934 OWDP
 5/9 O.T.D. 3434 To deepen
 5/18 Rig
 5/25 Top chert 3430-35
 Oil 3451-55 200' fluid
 T.D. 3478 7sq.

-OVER-

6/6 TD 3478
60 oil & 70 water.

COMPLETED

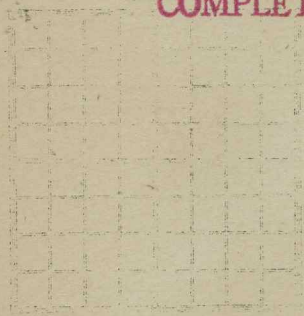

Map No. 1 **KANSAS** Sec. 14 Twp. 34 R. 2EWell No. 1-TamarkHarris & Hanna Company

Contractor

SECTION PLAT

	0		

Ft. from N. Line

645 Ft. from S. Line660 Ft. from E. Line

Ft. from W. Line

COMPLETED

Location

Rig up

Drilling and Remarks:

Sand 3425 ft
3433 ft9 M. Gas
800 # R.R. 6 ft

RECORD

Cased _____ in., _____ ft.

Sand _____

Gas _____

Oil _____

Total Depth _____

PRODUCTION

1st 24 hrs. Nat. _____

1st 24 hrs. after shot _____

Gas _____ Cu. Ft.

Dry Hole _____

Abandoned _____

Date

MAR 7 1928

S. J. LEWIS

Scout

Map No. 1 Sec. 14 Twp. 34 R. 2EWell No. 1-TamarkHome Nat. Gas Company

Contractor

CORRECTIONFeet measured
from 645 South to 660 South**FIRST REPORTS**

SECTION PLAT

	0		

Ft. from N. Line

660 Ft. from S. Line660 Ft. from E. Line

Ft. from W. Line

Case

Location

Rig up

Drilling and Remarks:

0 + 0 34 34 ftdo not have
record of old
well.

RECORD

Cased _____ in., _____ ft.

Sand _____

Gas _____

Oil _____

Total Depth _____

PRODUCTION

1st 24 hrs. Nat. _____

1st 24 hrs. after shot _____

Gas _____ Cu. Ft.

Dry Hole _____

Abandoned _____

Date

5-9-34

19

ORVAL MANNSCHRECK

Scout

Map No. 1 Sec. 14 Twp. 34 R. 2EWell No. 1-TamarkHornet Gas Company

Contractor

COMPLETED

SECTION PLAT

	0		

Ft. from N. Line

660 Ft. from S. Line660 Ft. from E. Line

Ft. from W. Line

Location _____

Rig up _____

Drilling and Remarks:

60 oil
70 water

RECORD

Cased _____ in., _____ ft.

Sand _____

Gas _____

Oil _____

Total Depth 3478

PRODUCTION

1st 24 hrs. Nat. _____

1st 24 hrs. after shot _____

Gas _____ Cu. Ft.

Dry Hole _____

Abandoned _____

Date

6-6-31 19**ORVAL MANNSCHRECK**
ScoutMap No. KANSAS Sec. 14 Twp. 34 R. 2EWell No. 1-TamarkHarris & Hahn Company

Contractor

SECTION PLAT

	0		

Ft. from N. Line

645 Ft. from S. Line660 Ft. from E. Line

Ft. from W. Line

FIRST REPORTS

Location _____

Rig up _____

Drilling and Remarks:

Rig

RECORD

Cased _____ in., _____ ft.

Sand _____

Gas _____

Oil _____

Total Depth _____

PRODUCTION

1st 24 hrs. Nat. _____

1st 24 hrs. after shot _____

Gas _____ Cu. Ft.

Dry Hole _____

Abandoned _____

Date

DEC 14 1927 192**S. J. LEWIS**

Scout