


Section 16 Township 34 Range 1E

Well No. #3 Hunt

Company Herndon Drlg.

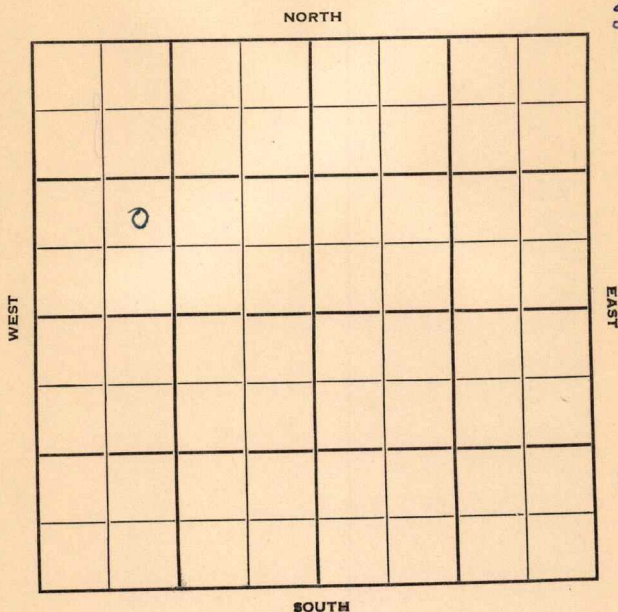

Sumner

KANSAS

Sec. 16 Twp. 34 R. 1E

Well No. #3 Hunt Farm

Herndon Drlg. Company

Herndon Drlg. - Contr. Contractor

Cortland Pool


 Ft. from N. Line

990' Ft. from S. Line

 Ft. from E. Line

990' Ft. from W. Line

NE SW NW

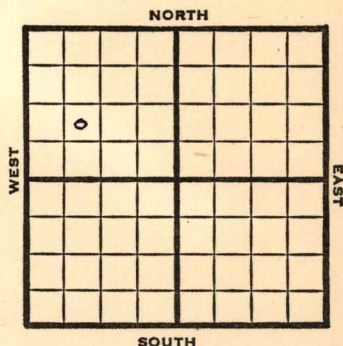

1950 **Elev 1185'** REPORT

10/4 Spud 9-30-50
10" @ 402'
Drlg.

11/15 10" @ 402
Miss 3642

Simp 3990

TD 3995
5" @ 3991
DD 3997
SO @ 99

FU 2500' oil 2 hr DD 4002

F/60 boph

Comp 90 bopd 12 bw

TD 4002

Completed

COMPLETED


County Sumner State Kansas

Sec. 16 (Blk. Twp.) 34 (Sur. Rge.) 1E Map No.

Operator Herndon Drlg.

Well No. 3 Farm Hunt

Elev. 1185 Location NE SW NW

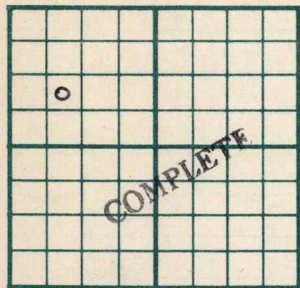

990 Ft. From S Line NW

990 Ft. From W Line Quarter

1st. Report

Completion NOV 15 1955

Remarks Cortland Pool

Herndon Drlg. - Contr.

Spudding Date 9-30-50

Drlg. Data Oil well TD 4002

10" @ 402 Miss. 3642 Simp. 3990 TD 3995

5" @ 3991 DD 3997 SO @ 99

FU 2500' oil 2 hr. DD 4002 F/ 60 boph

Comp. 90 bopd 12 bw

J. E. TYRA