


Section 16 Township 34 Range 1 E

Well No. # 6 Hunt

Company Herndon Drlg.

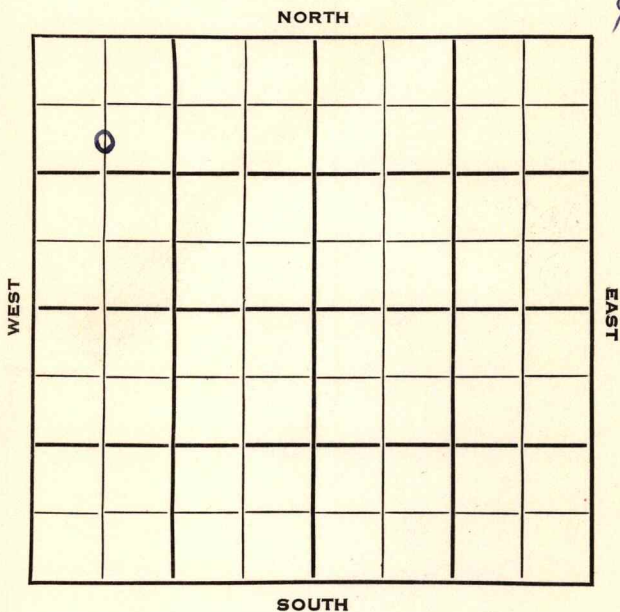

Sec. 16 Twp. 34 R. 1 E

Well No. # 6 Hunt Farm

Herndon Drlg. Company

Herndon Drlg. Contractor

**Portland Pool**


990 Ft. from N. Line

\_\_\_\_\_ Ft. from S. Line

\_\_\_\_\_ Ft. from E. Line

660 Ft. from W. Line

C S L NW NW

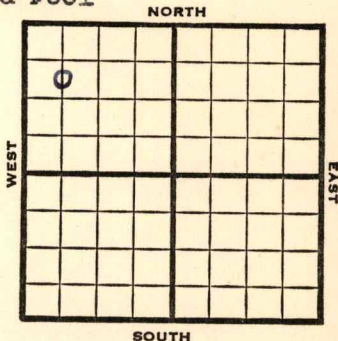

1953

**Elev. 1185'**

REPORT

5/13

Spud 5-9-53  
8" @ 450 WOC

6/10

Spud 5-9-53 Oil well TD 3068  
8" @ 450 **Layton 3030**  
DST 3027-54 open 40 min rec 420' oil  
1120#  
DST 3031-68 open 1/2 hr rec 230' oil  
TD 3068 5" @ 3030 CO to 3068  
FU to top w/oil  
Comp. 141 BOPD

**COMPLETED**



