FORM 51 25M 8-50 WESTERN

Sumner


KANSAS

Section 16 Township 34 Range 1E

Well No. #3 Wright

Company Herndon Drlg.

12

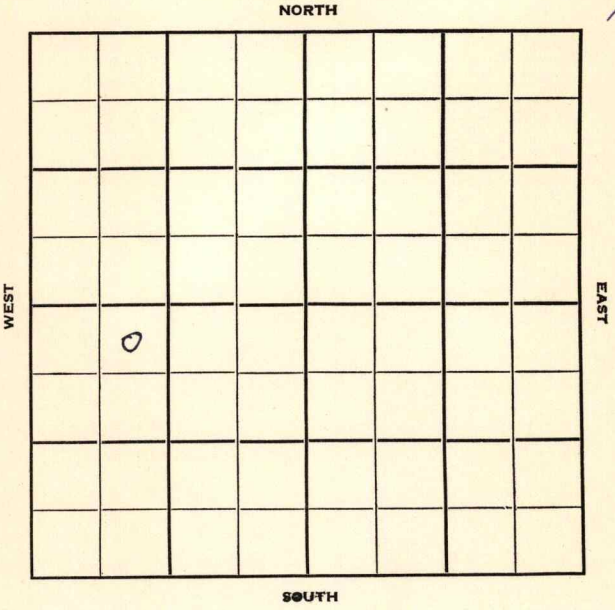

FORM 252-B
10M 11-50 PETROL

Sumner KANSAS

Sec. 16 Twp. 34 R. 1 E

Well No. #3 Wright Farm

Herndon Drlg. Company

Herndon Drlg. Contractor

330 Ft. from N. Line


Ft. from S. Line

Ft. from E. Line

990 Ft. from W. Line

NE NW SW

Portland

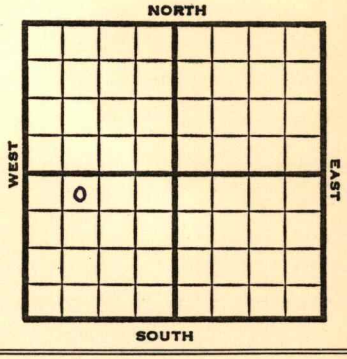

1951	Elev.1188' REPORT
2/7	Spud 1/28/51 8" @400 Drlg. 2375'
4/25	Spud 1-28-51 Oil Well TD 4005 8" @ 400 Layton 3020 KC 3200 Peru 3303 Oswego 3375 Miss 3668 Chattanooga 3942 Simp 3996 TD 4005 5" @ 3997 S/15 boph Comp. 21 bopd 92% w COMPLETED

FORM 275 FOR SALE BY KANSAS BLUE PRINT CO.

County Sumner State Kansas

Sec. 16 (Blk. Twp.) 34 (Sur. Rge.) 1E Map No.

Operator Herndon Drlg.

Well No. 3 Farm Wright

Elev. Location NE NW SW

FIRST REPORT

O

330 Ft. From N Line SW

990 Ft. From W Line Quarter

1st. Report FEB 7 1951

Completion

Remarks

Herndon Drlg. - Contr.

Spudding Date 1-28-51

Drlg. Data Portland Pool

8" @ 400 drlg. 2375

J. E. TYRA

FORM 275 FOR SALE BY KANSAS BLUE PRINT CO.

County Sumner State Kansas

Sec. 16 (Blk. Twp.) 34 (Sur. Rge.) 1E Map No.

Operator Herndon Drlg.

Well No. 3 Farm Wright

Elev. 1188 Location NE NW SW



330 Ft. From N Line SW

990 Ft. From W Line Quarter

1st. Report

Completion APR 25 1951

Remarks Portland Pool

Herndon Drlg. - Contr.

Spudding Date 1-28-51

Drlg. Data Oil well TD 4005

8" @ 400 Layton 3020 KC 3200

Peru 3303 Oswego 3375 Miss. 3668

Chattanooga 3942 Simp. 3996 TD 4005

5" @ 3997 S/ 15 boph Comp. 21 bopd 92%w

J. E. TYRA