

COPY

SIDE ONE

STATE CORPORATION COMMISSION OF KANSAS
OIL & GAS CONSERVATION DIVISION
WELL COMPLETION FORM
ACO-1 WELL HISTORY
DESCRIPTION OF WELL AND LEASE

Operator: License # 30084Name: Stroud Oil Properties, Inc.Address 200 E. First Suite 00City/State/Zip Wichita, Kansas 67202

Purchaser: _____

Operator Contact Person: George R. JonesPhone (316) 262-5503Contractor: Name: Kephart Drilling, Inc.License: 5379Wellsite Geologist: William T. Stoeckinger

Designate Type of Completion

☒ New Well ☐ Re-Entry ☐ Workover☐ Oil ☐ SWD ☐ Temp. Abd.☒ Gas ☐ Inj ☐ Delayed Comp.☐ Dry ☐ Other (Core, Water Supply, etc.)☒ Coal Seam Gas

If OWMO: old well info as follows:

Operator: _____

Well Name: _____

Comp. Date _____ Old Total Depth _____

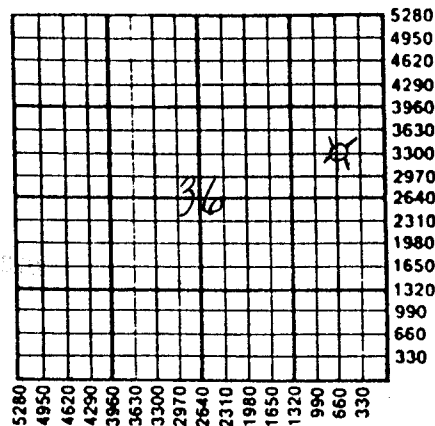
Drilling Method:

☒ Mud Rotary ☐ Air Rotary ☐ Cable8/2/90 8/6/90 8/7/90

Spud Date Date Reached TD Completion Date

API NO. 15- 099-22,837County LabetteC SE NE Sec. 36 Twp. 34 Rge. 17 ☒ East West3300 Ft. North from Southeast Corner of Section660 Ft. West from Southeast Corner of Section

(NOTE: Locate well in section plat below.)

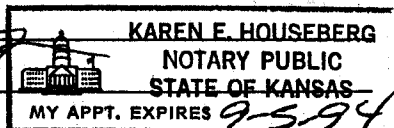
Lease Name Keith Well # 1Field Name WildcatProducing Formation Weir CoalElevation: Ground 810' KB _____Total Depth 896' PBD _____Amount of Surface Pipe Set and Cemented at 20 FeetMultiple Stage Cementing Collar Used? ☐ Yes ☒ No

If yes, show depth set _____ Feet

If Alternate II completion, cement circulated from 892feet depth to Surface w/ 90 sx cmt.

INSTRUCTIONS: This form shall be completed in triplicate and filed with the Kansas Corporation Commission, 200 Colorado Derby Building, Wichita, Kansas 67202, within 120 days of the spud date of any well. Rule 82-3-130, 82-3-107 and 82-3-106 apply. Information on side two of this form will be held confidential for a period of 12 months if requested in writing and submitted with the form. See rule 82-3-107 for confidentiality in excess of 12 months. One copy of all wireline logs and drillers time log shall be attached with this form. ALL CEMENTING TICKETS MUST BE ATTACHED. Submit CP-4 form with all plugged wells. Submit CP-111 form with all temporarily abandoned wells. Any recompletion, workover or conversion of a well requires filing of ACO-2 within 120 days from commencement date of such work.

All requirements of the statutes, rules and regulations promulgated to regulate the oil and gas industry have been fully complied with and the statements herein are complete and correct to the best of my knowledge.

Signature [Signature]Title President Date 1/14/91Subscribed and sworn to before me this 14 day of January, 1991Notary Public [Signature]Date Commission Expires 9-5-94

K.C.C. OFFICE USE ONLY
F ☐ Letter of Confidentiality Attached
C ☒ Wireline Log Received
C ☐ Drillers Timelog Received

Distribution
☒ KCC ☐ SWD/Rep ☐ NGPA
☒ KGS ☐ Plug ☐ Other (Specify) J

☒ Other (Specify) _____