


Section 17 Township 34 Range 1E

Well No. #1 Pasey

Company Herndon Drlg.

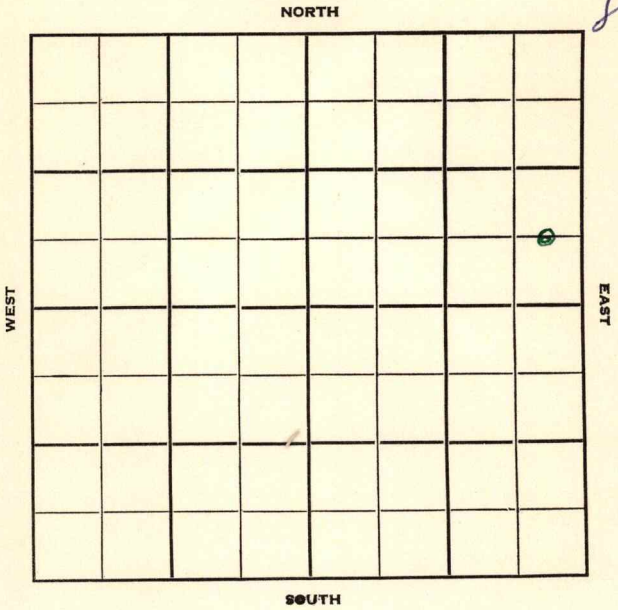

Sec. 17 Twp. 34 R. 1 E

Well No. # 1 Pasey Farm

Herndon Drlg. Company

Herndon Drlg. Contractor

Portland Pool


Ft. from N. Line

660 Ft. from S. Line

330 Ft. from E. Line

Ft. from W. Line

C E L S E N E

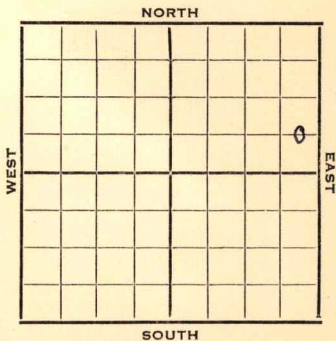

1951

Elev. 1178' REPORT

11/21

Spud 11-19-51
Drilling

1952
1/9

Spud 11-19-51
Oil Well TD 3992
8" @ 359
Layton 3012 1st sd 3031
2nd sd 3078 KC 3202
Lans. 3376 Cherokee 3500
Miss 3690 Wordford 3924
Simp. 3992 TD 3992
5" @ 3986 P/ 50 BO 1 hr.
P/ 40 BOPH 3 hhr.
Comp. BHB 2598 BOPD

COMPLETED

County Sumner State Kansas

Sec. 17 (Blk. 34) (Sur. 1E) Map No.

Operator Herndon Drlg.

Well No. 1 Farm Pasey

Elev. _____ Location C E L S E N E

660 Ft. From S Line NE

330 Ft. From E Line Quarter

Ist. Report NOV 21 1951

Completion _____

Remarks _____

Herndon Drlg. - Contr.

Spudding Date 11-19-51

Drlg. Data Portland Pool

drlg.

