

Section 17 Township 34 Range 1 E

Well No. # 3 Posey

Company Herndon Drlg.

1

NORTH

							0

WEST

EAST

SOUTH

Summer **KANSAS**

SEC. 17 TWP. 34 R. 1 E ✓

WELL NO. # 3 Posey FARM

COMPANY Herndon Drlg.

CONTRACTOR Herndon Drlg.


Portland Pool
990 Ft. from N. Line

Ft. from S. Line

330 Ft. from E. Line

Ft. from W. Line

SE NE NE

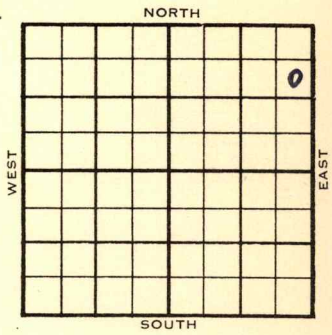

1953 ELEVATION 1164' REPORT

9/9 Spud 9-5-53
8" @ 362
Drlg. 1185'

9/30 Spud 9-5-53
8" @ 362'
Layton 3034
TD 3070'
D & A

ABANDONED

