

Sumner

KANSAS

18

34

2E

SECTION _____ TOWNSHIP _____ RANGE _____

#1 Metzinger

WELL NO. _____

O. A. Sutton


COMPANY _____

NORTH

7

WEST

EAST

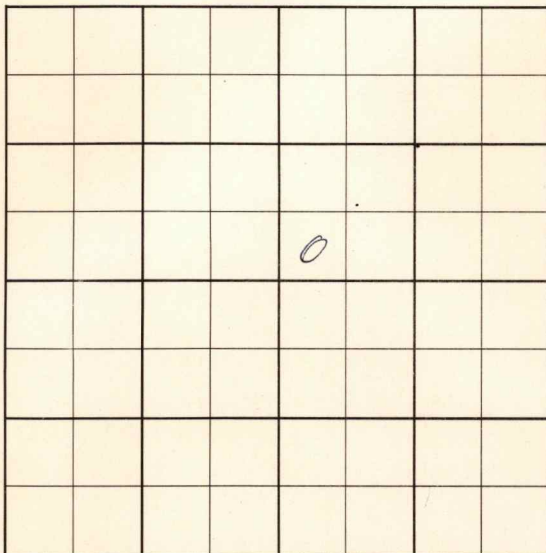

SOUTH

Sumner

KAN 543

SEC.	18	TWP.	34	R.	2E
------	----	------	----	----	----

WELL NO. #1 Metzinger

COMPANY O. A. Sutton


CONTRACTOR Renfro

_____ FT. FROM N. LINE

_____ FT. FROM S. LINE

_____ FT. FROM E. LINE

_____ FT. FROM W. LINE

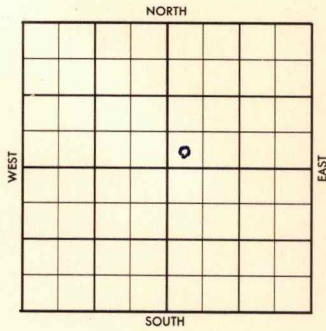

SW SW NE

1956	ELEVATION	REPORT
------	-----------	--------

9-12	Location
------	----------

County Summer Elev. _____
 Sec. 18 Twp. 34 Rge. 2E
 Company O. A. Sutton
 Farm Name Metzinger No. 1

TOPS	DEPTH	LOG	DATUM	Loc. in Sec.
Anh.				SW SW NE
Tp.				
H.				
Tr.				
Dg.				
Bl.				
L.				Geol. _____
K.C.				Contr. _____
B.K.C.				<u>Renfro</u>
Ce.				Pool _____
C.				
M.				
M.				
K.				
Mz.				
Mq.				
V.				
S.				
S.				
A.				
R.				
Pe.				
G.				
TD.				

SEP 2 '55

FIRST REPORT

Date Comm. _____

Location _____

SEP 1 1955

SEP 1 1955

29

County Sumner Elev. 1235
 Sec. 18 Twp. 34 Rgn. 2E
 Company O. A. Sutton
 Farm Name Metzinger No. 1

TOPS	DEPTH	LOG	DATUM	Loc. in Sec.
Anb.				SW SW NE
Tr.				
H.				
Tr.				
Dg.				
BL.				
L.				
K.C.				Geol.
B.K.C.				Cantr.
Ce.				Renfro
C.				Pool
M.				
M.				
K.				
Mz.				
Me.				
V.				
S.				
S.				
A.				
R.				
Pe.				
G.				
T.D.				

OCT 10 1956

Date Comm.

Location SEP 19 '56 SEP 26 '56 C & D OCT 3 '56
 OCT 10 '56

Abd Lac.