


Section 19 Township 34 Range 2 E


Well No. # 2 Miller

Company O. H. Parker

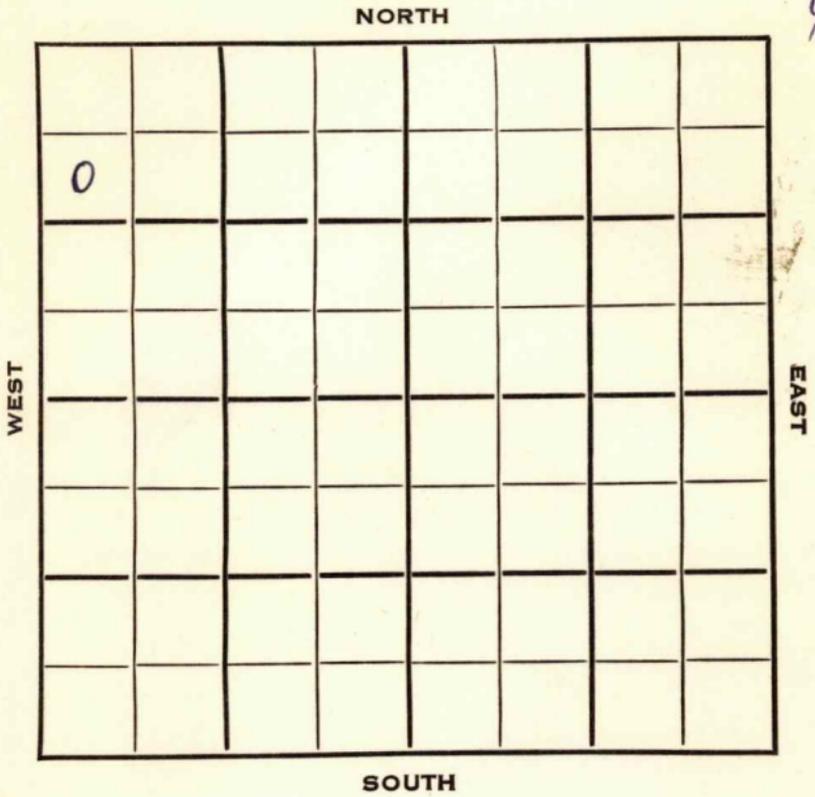

SEC. _____ TWP. Sumner R. KANSAS ✓
 WELL NO. 19 34 2 E
 COMPANY # 2 Miller FARM
 CONTRACTOR O. H. Parker

H. J. Uhl
Wildcat
990 Ft. from N. Line
 _____ Ft. from S. Line
 _____ Ft. from E. Line
330 Ft. from W. Line

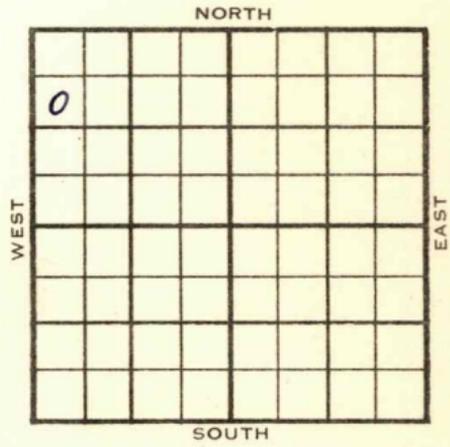

SW NW NW

	ELEVATION	REPORT
1954	1203'	
4/14	MIR	
7/28	Spud 4-13-54	
	Oil Well	
	TD 3275'	
	8" @ 190'	
	Stal. 2455', Layton 2911', Cleve 3200'	
	DST 3192-3230', opn 40', rec. 60' ocm,	
	TD 3275'	
	5" @ 3267'	
	CO to 3240'	
	88/3210-32, FU 100' oil, 40' wtr, frac	
	E/25 bopd 40% wtr.	
	omp. 50 bopd 30 bw	

COMPLETED

County Sumner State Kansas
 Sec. 19 (Blk. 34 (Sur. 2E (Twp.) (Rge.) Map No.
 Operator O. H. Parker
 Well No. 2 Farm Miller
 Elev. 1203 Location SW NW NW

990 Ft. From N Line NW
330 Ft. From W Line Quarter
 Ist. Report
 Completion JUL 28 1954
 Remarks Wildcat
H. J. Uhl - Contr.
 Spudding Date 4-13-54

Drlg. Data Oil well TD 3275
8" @ 190 Stal. 2455 Layton 2911
Cleve. 3200 DST 3192-3230 open 40 min.
Rec. 60' ocm TD 3275 5" @ 3267
CO to 3240 88/ 3210-32 FU 100' oil
40' wtr. frac F/ 25 bopd 40% wtr.
Comp. 50 bopd 30 bw