

KANSAS DRILLERS LOG

S. 35 T. 34 R. 2 E
W
Loc. SW NW NW

API No. 15 — 191 — 20,619
County Number

County Sumner

Operator
The Everly Co., Inc.

Address
P. O. Box 762 Winfield, Kansas 67156


Well No. #1-A Lease Name Metzinger

Footage Location 270
feet from (N) (S) line feet from (E) (W) line

Principal Contractor DNB Drilling Co. Geologist George R. McNeish

Spud Date September 8, 1976 Total Depth 3150 P.B.T.D.

Date Completed September 13, 1976 Oil Purchaser Apco Refining

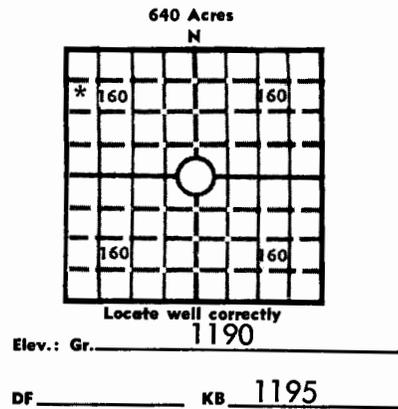

CASING RECORD

Report of all strings set — surface, intermediate, production, etc.

Purpose of string	Size hole drilled	Size casing set (in O.D.)	Weight lbs/ft.	Setting depth	Type cement	Sacks	Type and percent additives
Surface	12 1/4	8 5/8		215	Common	175	
Production	7 7/8	4 1/2"	10.50	3149	Pozmix	350	

LINER RECORD

PERFORATION RECORD

Top, ft.	Bottom, ft.	Sacks cement	Shots per ft.	Size & type	Depth interval
			2	Jet	3095-97
			2	Jet	3105-12

TUBING RECORD

Size	Setting depth	Packer set at

ACID, FRACTURE, SHOT, CEMENT SQUEEZE RECORD

Amount and kind of material used	Depth interval treated
500 gallon acid	3095-97 & 3105-12
500 bbl. water 10,000 lbs. sand	3095-97 & 3105-12

INITIAL PRODUCTION

Date of first production <u>March 5, 1977</u>	Producing method (flowing, pumping, gas lift, etc.) <u>Flowing</u>
RATE OF PRODUCTION PER 24 HOURS	Oil <u>1</u> bbls. Gas <u>2,000</u> MCF Water <u>4</u> bbls. Gas-oil ratio
Disposition of gas (vented, used on lease or sold) <u>sold</u>	Producing interval (s) <u>Cleveland 3091-3121</u>

INSTRUCTIONS: As provided in KCC Rule 82-2-125, within 90 days after completion of a well, one completed copy of this Drillers Log shall be transmitted to the State Geological Survey of Kansas, 4150 Monroe Street, Wichita, Kansas 67209. Copies of this form are available from the Conservation Division, State Corporation Commission, 3830 So. Meridian (P.O. Box 17027), Wichita, Kansas 66217. Phone AC 316-522-2206. If confidential custody is desired, please note Rule 82-2-125. Drillers Logs will be on open file in the Oil and Gas Division, State Geological Survey of Kansas, Lawrence, Kansas 66044.

Operator The Everly Company, Inc.

DESIGNATE TYPE OF COMP.: OIL, GAS, DRY HOLE, SWDW, ETC.:
gas

Well No. A-1 Lease Name Metzinger

S 35 T 34 R 2 E WX SW NW NW

WELL LOG

Show all important zones of porosity and contents thereof; cored intervals, and all drill-stem tests, including depth interval tested, cushion used, time tool open, flowing and shut-in pressures, and recoveries.

SHOW GEOLOGICAL MARKERS, LOGS RUN, OR OTHER DESCRIPTIVE INFORMATION.

FORMATION DESCRIPTION, CONTENTS, ETC.	TOP	BOTTOM	NAME	DEPTH
<p>Induction - Electrical Log</p> <p>Compensated formation density</p>				

USE ADDITIONAL SHEETS, IF NECESSARY, TO COMPLETE WELL RECORD.

Date Received

John A. Everly
Signature

President
Title

June 14, 1977
Date

State Geological Survey
WICHITA, BRANCH

DRILLERS' LOG

THE EVERLY COMPANY, INC.
No. 1-A Metzinger ³⁴
SW NW NW, Sec. 35-248-2E
Sumner County, Kansas

15-191-20619

Elev: 1189 G.L.

Commenced: 9-8-76
Completed: 9-14-76

Surface Casing: 207' of
8-5/8" cemented w/175 sx
common cement, 2% Gel, 3% cc.
9-9-76

FORMATION

DEPTH

Surface Hole	0 - 215
Shale & Lime	215 - 1092
Shale, Sand & Lime	1092 - 1550
Shale & Lime	1550 - 2253
Shale, Sand & Lime	2253 - 2564
Shale & Lime	2564 - 2772
Sand	2772 - 2776
Sand & Shale	2776 - 2860
Lime	2860 - 3105
Shale & Sand	3105 - 3130
Lime & Shale	3130 - 3150 RTD

I do hereby certify that the foregoing statements are true and correct to the best of my knowledge and belief.

D N B DRILLING, INC.

James L. Donelson
JAMES L. DONELSON

STATE OF KANSAS: ss:

Subscribed and sworn to before me this 16th day of Sept. 1976.

Ella Priess

Ella Priess, Notary Public

