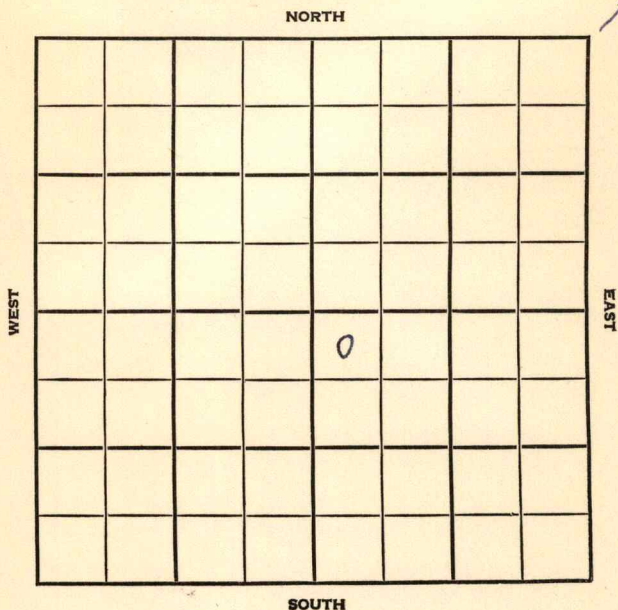


Section 2 Township 34 Range 2 EWell No. # 1 PaltonCompany McNeish & Gralapp

Sumner

KANSAS

SEC.	TWP.	R.
2	34	2 E

WELL NO.

1 Palton

FARM

COMPANY

McNeish & Gralapp

CONTRACTOR

Co. tools

Wildcat


330 _____ Ft. from N. Line

_____ Ft. from S. Line

_____ Ft. from E. Line

330 _____ Ft. from W. Line

NW NW SE

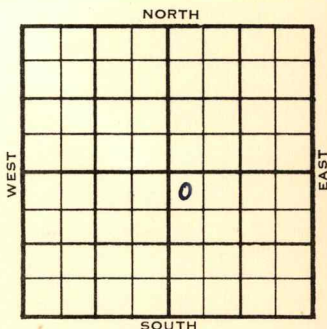

ELEVATION

REPORT

1955

1108'

2/9

MIR

2/23

Spud 2-9-55 D & A TD 3407
 8" @ 150 Layton 2716 KC 2886
 Oswego 3081' Miss 3395 TD 3407
 D & A

ABANDONED

County **Sumner** State **Kansas**

Sec. **2** (Blk.) **34** (Sur.) **2E** Map No.

Operator McNeish & Gralapp

Well No. 1 Farm Palton

[illegible]

FIRST REPORT

330 Ft. From N Line SE

330 Ft. From W Line Quarter

1st. Report FEB 9 1955

Completion

Remarks

Co. tools

Spudding Date _____

Drlg. Data Wildcat

MIR

FABEN GILSTRAP

County Sumner State KansasSec. 2 (Blk. Twp.) 34 (Sur. Rge.) 2E Map No.Operator McNeish & GralappWell No. 1 Farm PattonElev. 1108 Location NW NW SE330 Ft. From N Line SE330 Ft. From W Line Quarter1st. ReportCompletion FEB 23 1955Remarks WildcatCo. toolsSpudding Date 2-9-55Drlg. Data D & A TD 34078" @ 150 Layton 2716 KC 2886Oswego 3081 Miss. 3395 TD 3407D & A

EABEN GILSTRAP