

KANSAS WELL COMPLETION REPORT

API No. 15 - 099 - 20085

Sec. 16 T. 34 R. 20 E.

Year well reported \_\_\_\_\_

Spot SW 1/4 SE 1/4


County Labette

Company Bur. of Mines

Farm & Well No. 10 Leap.

Contractor B+N Drilling Co.

Please show location of well in section:

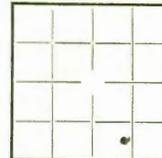

Date drilling comm. 10/26/72

Elev: Kelly Bushing \_\_\_\_\_

Date drilling comp. 10/28/72

Derrick floor \_\_\_\_\_

Ground \_\_\_\_\_

Field name North Bartlett ?

Electric or other logs were run: Yes \_\_\_\_\_ No X

Hole was completed as: Dry \_\_\_\_\_; Oil well \*;

Well was cored: Yes \_\_\_\_\_ No X

Water-flood producer \_\_\_\_\_; Gas well \_\_\_\_\_;

Drill stem test run: Yes \_\_\_\_\_

Salt-water disposal \_\_\_\_\_; Other (name) Research

No X

INITIAL POTENTIAL OR PRODUCTION:

FORMATION TOPS

Bbls oil/day 0, Bbls water/day -,

List below:

Thou cu ft gas/day -.

Bartlesville 254

Oil gravity 15 °API

Name of pay zone Bartlesville

Pay depth (bottom) 360

Net pay thickness 106

Name of rock formation at total depth Bartlesville

Total depth 360

Company purchasing oil or gas: \_\_\_\_\_

CASING

List: 10" @ 6'  
7" @ 295'

If OWWO\*, give new footage drilled \_\_\_\_\_  
\* Old well drilled deeper

10/15/1970

This well completion form is mailed to southeastern Kansas operators, because commercial reporting companies do not scout the area. Completed forms, driller's logs, electric logs, and other information submitted to us will be placed on open file for your use. Please complete form and mail in enclosed envelope to Margaret Oros, Head, Oil and Gas Division, State Geological Survey, Lindley Hall, Lawrence, Kansas 66044. Phone: 913-864-3852.

Minimum completion information will be used for reporting all wells completed in Kansas to American Association of Petroleum Geologists' Committee on Statistics of Drilling. These statistics are published by the Oil and Gas Journal, American Association of Petroleum Geologists, U. S. Bureau of Mines, and others.



**KANSAS DRILLERS LOG**

*State Geological Survey  
WICHITA, BRANCH*

API No. 15 — 099 — 20085  
County Number

S. 16 T. 34 R. 20 <sup>E</sup><sub>W</sub>  
Loc. SE SW SE  
County Labette

Operator  
**Bureau of Mines**

Address  
P. O. Box 1398 Bartlesville, Ok. 74003


Well No. #10 Lease Name Leap

Footage Location  
319 feet from (M) (S) line 1580 feet from (E) (W) line

Principal Contractor B & N Drilling Co. Geologist ---

Spud Date Oct. 26, 1972 Total Depth 360 P.B.T.D.

Date Completed Oct. 28, 1972 Oil Purchaser ---

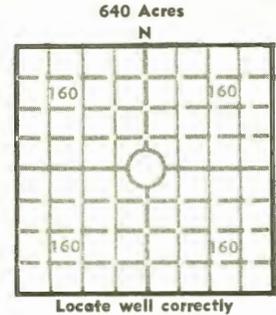

Elev.: Gr. \_\_\_\_\_  
DF \_\_\_\_\_ KB \_\_\_\_\_

**CASING RECORD**

Report of all strings set — surface, intermediate, production, etc.

Purpose of string	Size hole drilled	Size casing set (in O.D.)	Weight lbs/ft.	Setting depth	Type cement	Sacks	Type and percent additives
Surface	12	10	-	6	Common	-	-
Production	9"	7	23	295	Common	to surface	w/40% silica flour and 4% CaCl

**LINER RECORD**

**PERFORATION RECORD**

Top, ft.	Bottom, ft.	Sacks cement	Shots per ft.	Size & type	Depth interval
None					

Size	Setting depth	Packer set at
None		

**ACID, FRACTURE, SHOT, CEMENT SQUEEZE RECORD**

Amount and kind of material used	Depth interval treated
None	

**INITIAL PRODUCTION**

Date of first production Research Well Producing method (flowing, pumping, gas lift, etc.) \_\_\_\_\_

RATE OF PRODUCTION PER 24 HOURS	Oil	Gas	Water	Gas-oil ratio
	----- bbls.	----- bbls.	----- MCF	----- CFPB

Disposition of gas (vented, used on lease or sold) --- Producing interval (s) 295 - 360

INSTRUCTIONS: As provided in KCC Rule 82-2-125, within 90 days after completion of a well, one completed copy of this Drillers Log shall be transmitted to the State Geological Survey of Kansas, 4150 Monroe Street, Wichita, Kansas 67209. Copies of this form are available from the Conservation Division, State Corporation Commission, 3830 So. Meridian (P.O. Box 17027), Wichita, Kansas 66217. Phone AC 316-522-2206. If confidential custody is desired, please note Rule 82-2-125. Drillers Logs will be on open file in the Oil and Gas Division, State Geological Survey of Kansas, Lawrence, Kansas 66044.

Operator U.S. Bureau of Mines DESIGNATE TYPE OF COMP.: OIL, GAS, DRY HOLE, SWDW, ETC.:

Well No. 10 Lease Name Leap Oil (Research Well)

S 16 T 34 SR 20 E


**WELL LOG**

Show all important zones of porosity and contents thereof; cored intervals, and all drill-stem tests, including depth interval tested, cushion used, time tool open, flowing and shut-in pressures, and recoveries.

SHOW GEOLOGICAL MARKERS, LOGS RUN, OR OTHER DESCRIPTIVE INFORMATION.

FORMATION DESCRIPTION, CONTENTS, ETC.	TOP	BOTTOM	NAME	DEPTH
Soil	-	2	Bartlesville	254 - 360
lime	2	18		
shale	18	20		
lime	20	22		
shale	22	134		
lime	134	140		
shale	140	146		
lime	146	148		
shale	148	176		
lime	176	178		
shale	178	206		
lime	206	208		
shale	208	252		
lime	252	254		
shaly sand	254	290		
sand	290	295		
shaly sand	295	310		
sand	310	360		

USE ADDITIONAL SHEETS, IF NECESSARY, TO COMPLETE WELL RECORD.

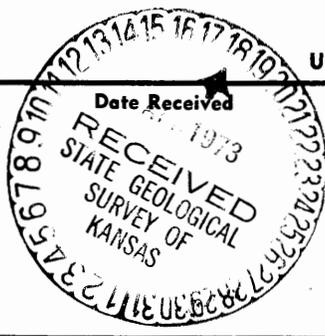

Larman J. Heath  
 Signature  
 Project Leader  
 Title  
 3/29/73  
 Date