


Give All Information Completely
Make Required Affidavit
Mail or Deliver Report to:
Conservation Division
State Corporation Commission
211 No. Broadway
Wichita, Kansas

WELL PLUGGING RECORD

NORTH

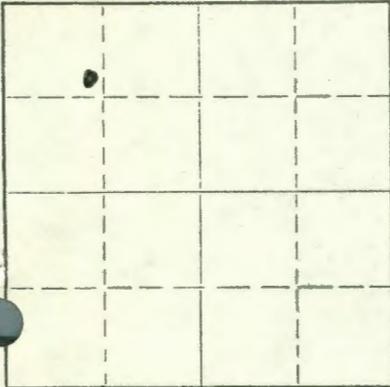

Locate well correctly on above
Section Plat

Labette

County. Sec. 9 Twp. 34S Rge. 20 (E) 3 (W) X

Location as "NE/CNW%SW%" or footage from lines 1420' NSL, 1270' EWL NW/4

Lease Owner CFA, Inc. and Associated Oil and Gas Co.

Lease Name M. Donald Well No. CH #1

Office Address P. O. Box 445, Wellington, Kansas

Character of Well (completed as Oil, Gas or Dry Hole) Core Hole

Date well completed 9-26 1965

Application for plugging filed 9-26 1965

Application for plugging approved 9-26 1965

Plugging commenced 9-26 1965

Plugging completed 9-26 1965

Reason for abandonment of well or producing formation _____

If a producing well is abandoned, date of last production _____ 19____

Was permission obtained from the Conservation Division or its agents before plugging was commenced? Yes.

Name of Conservation Agent who supervised plugging of this well Bert Wilcox
Producing formation None. Depth to top _____ Bottom _____ Total Depth of Well 580 Feet

Show depth and thickness of all water, oil and gas formations.

OIL, GAS OR WATER RECORDS

CASING RECORD

FORMATION	CONTENT	FROM	TO	SIZE	PUT IN	PULLED OUT
				<u>8-5/8"</u>	<u>25'</u>	<u>None.</u>

Describe in detail the manner in which the well was plugged, indicating where the mud fluid was placed and the method or methods used in introducing it into the hole. If cement or other plugs were used, state the character of same and depth placed, from _____ feet to _____ feet for each plug set.

Spotted 7 sx cement @ 580'.
Bridge and 8 sx cement @ 150'.
Bridge and 3 sx cement @ 65'.
Dirt to 8' and 2 sx cement.

Note: Location on Intent to Drill should read 1420' NSL, 1270' EWL NW/4

(If additional description is necessary, use BACK of this sheet)

Name of Plugging Contractor Ace-Hi Drilling Co.
Box 429, Chanute, Kansas