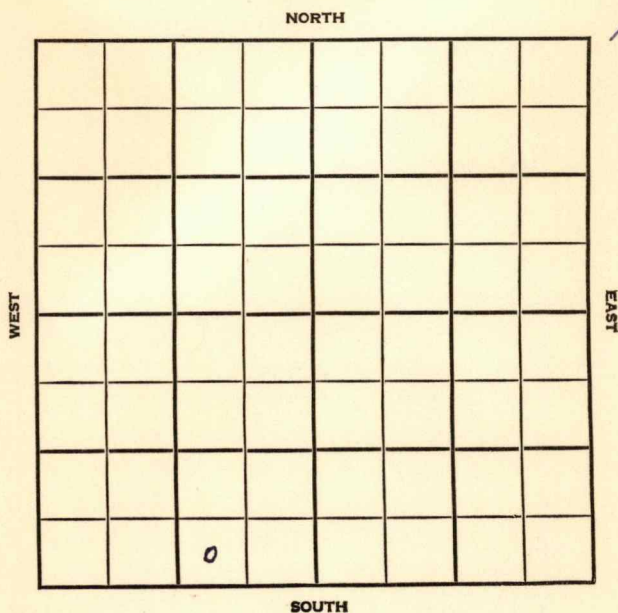


Section 21 Township 34 Range 2EWell No. #1 WalinCompany McKnab Drlg. Inc.

Sumner

|      |      |    |
|------|------|----|
| SEC. | TWP. | R. |
| 21   | 34   | 2E |

WELL NO.

#1 Walin

FARM

COMPANY

McKnab Drlg., Inc.

CONTRACTOR


Co. Tools.

\_\_\_\_\_ Ft. from N. Line

330 \_\_\_\_\_ Ft. from S. Line

990 \_\_\_\_\_ Ft. from E. Line

\_\_\_\_\_ Ft. from W. Line

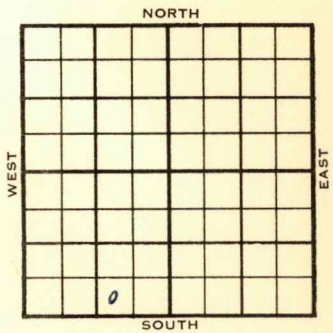

SW SE SW

|      | ELEVATION | REPORT |
|------|-----------|--------|
| 1954 | 1207'     |        |

10/20 Spud 10-13-54  
8" @ 120'  
Drlg. 1995'

10/27 Spud 10-13-54 D & A TD 3548  
8" @ 120 Br. lime 2375 Stal. 2420  
Layton 2838 KC 3032 Cleve 3177  
Oswego 3221 Miss 3500 TD 3548'  
D & A  
**ABANDONED**

FABEN GILSTRAP

County Sumner State Kansas  
 Sec. 21 (Blk. 34 (Sur. 2E Map No.  
 (Twp. (Rge.  
 Operator McKnab Drlg, Inc.  
 Well No. 1 Farm Walin  
 Elev. 1207 Location SW SE SW



330 Ft. From S Line SW  
990 Ft. From E Line Quarter  
 1st. Report  
 Completion OCT 27 1954  
 Remarks

Co. tools  
 Spudding Date 10-13-54

Drlg. Data D & A TD 3548  
8" @ 120 Br. lime 2375 Stal. 2420  
Layton 2838 KC 3032 Cleve. 3177  
Oswego 3221 Miss. 3500 TD 3548  
D & A

FABEN GILSTRAP