


Sumner

KANSAS

SECTION 21 TOWNSHIP 34 RANGE 2 E

WELL NO. #1 Walin "B"

COMPANY McKnab Drlg.

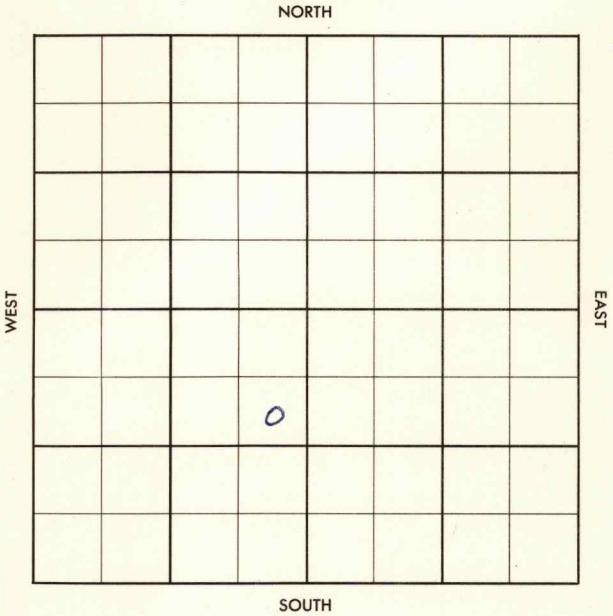

Sumner

KANSAS

SEC. 21	TWP. 34	R. 2E
------------	------------	----------

WELL NO.

#1 Walin "B"

FARM

COMPANY

McKnab Drlg.

CONTRACTOR

Co. tools


W. Padgett

_____ Ft. from N. Line

_____ Ft. from S. Line

_____ Ft. from E. Line

_____ Ft. from W. Line

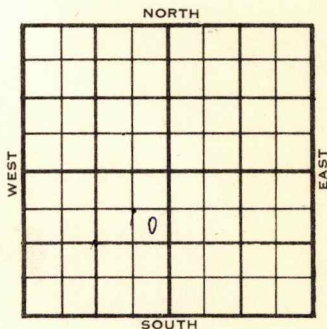

SE NE SW

	ELEVATION	REPORT
1956	1212 DF, 1215 KB	
1-25	Comm. 1-20-56 8" @ 115/110 Drlg. 1450	
2-8	DST 3040-60 op 1 hr. rec. 30' SOCM, BHP 90/20 No log. D & A Stal. 2415 Lay. 2844 KC 3036 Clev. 3176 M. 3510 TD 3540	

ABANDONED

County Sumner Elev. _____
 Sec. 21 Twp. 34 Rge. 2E
 Company McKnab Drlg.
 Farm Name Walsh "B" No. 1

TOPS	DEPTH	LOG	DATUM	Loc. in Sec.
Anh.				SE NE SW
Tp.				
H.				
Tr.				
Dg.				
BL.				
L.				Geol.
K.C.				Contr.
B.K.C.				Co. tools
Ce.				Pool
C.				W. Padgett
M.				
M.				
K.				
Mz.				
Mq.				
V.				
S.				
S.				
A.				
R.				
Pf.				
G.				
T.D.				

AN 25 '56
 FIRST REPORT
 0

Date Comm. 1-20-56
8" @ 115/110 drlg. 1450

County **Sumner** Elev. **1213 OF**
 Sec. **21** Temp. **34** Rgs. **2E**
 Company **McKnab Drlg.**
 Farm Name **Walin "B"** No. **1**

TOPS	DEPTH	LOG	DATUM	Loc. in Sec.
Anh.				SE NE SW
Tp. 5701	2415		1203	
H. 404	2844		1632	
Tr.				
Dg.				
Bl.				
L.				
K.C.	3036		1824	Geol.
B.K.C. cler	3176		1964	Contr.
Ce.				Co. tools
C.				
M.	3510		2298	Pool
M.				
K.				
Mz.				W. Padgett
Ma.				
V.				
S.				
S.				
A.				
R.				
Pe.				
G.				
TD.	3540			

ABANDONED

Date Comm. **1-20-56** FEB 8 1956

8" @ 115/110 drlg. **1450** FEB 1 '56

DST 3040-60 or 1 hr. rel 30'

5.0 CM BHP 20/20 @ 3345

FEB 8 56 **No 409**

W & R