


Section 22 Township 34 Range 2E

Well No. 1 Thiessen

Company Anderson -Prichard

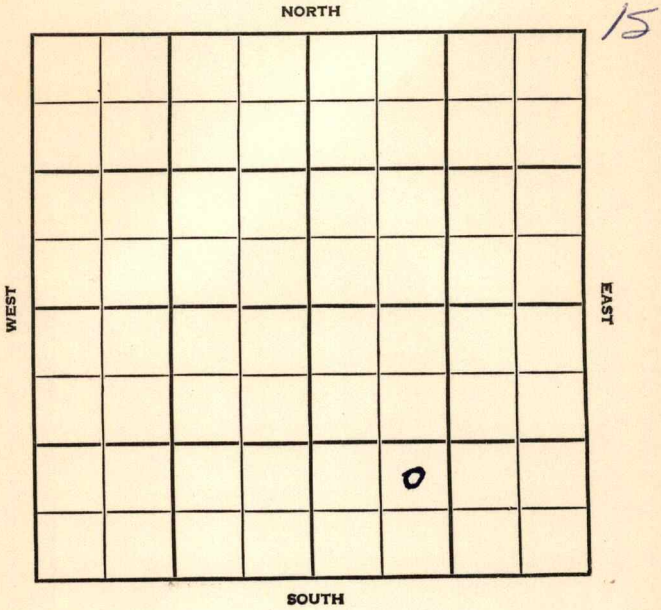

Sumner KANSAS

SEC.	TWP.	R.
22	34	2E

WELL NO. **1 Thiessen** FARM

COMPANY **Anderson-Prichard**

CONTRACTOR **Glen Peel**


Padgett Pool

_____ Ft. from N. Line

990 _____ Ft. from S. Line

_____ Ft. from E. Line

1220 _____ Ft. from W. Line

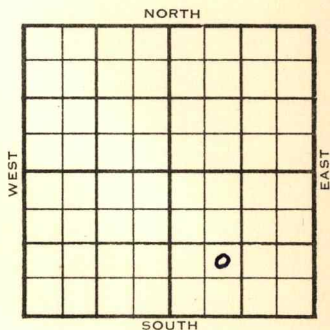

NE SW SE

1954	ELEVATION	REPORT
------	-----------	--------

1226'

7/28
9/1

M I R

Spud 7-28-54 - Oil Well

TD 3502'

8" @ 145'

Layton 2798'

DST 2799-2805', opn 1 hr., rec. 12' mud
130#

DST 2800-15', opn 1 hr., rec. 570' gas,
50' vsg & ocm, 270#

KC 2990'

DST 3000-12', opn 1 hr., rec. 360' gas,
25' so&gcm, 85#

Cleve. 3117'

DST 3119-61, opn 2 hrs., rec. 30' gcm,
180' o&gcm, 420#

**Uswego 3183', Miss 3473', Miss Chert
3495'**

DST 3488-3502', opn 1 hr., rec. 135'
O&GCM, 620#

TD 3502'

5" @ 3496'

CO to 3502'

DD 3507

100 M-A S/25 bo 13½ bw 24 hrs.

S/23 bo 9 bw 24 hrs.

Comp. 35 bopd 3 bw

COMPLETED

