

KANSAS


FORM 51 5M 6-46 PETROL

Summer

Section 22 Township 34 Range 2E

Well No. 2 Thiessen

Company Sterling Pet.

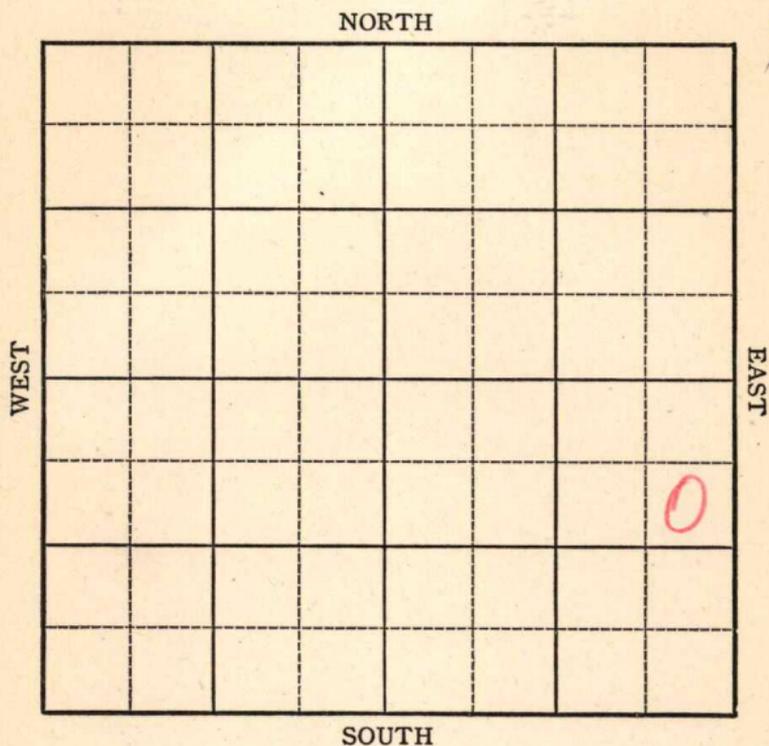

KANSAS

Summer County ✓

Sec. 22 Twp. 34 R. 2E

Well No. #2 Thiessen Farm

Sterling Pet. Company

Miscellaneous


990 Ft. from N. Line

_____ Ft. from S. Line

330 Ft. from E. Line

_____ Ft. from W. Line

SE NE SE

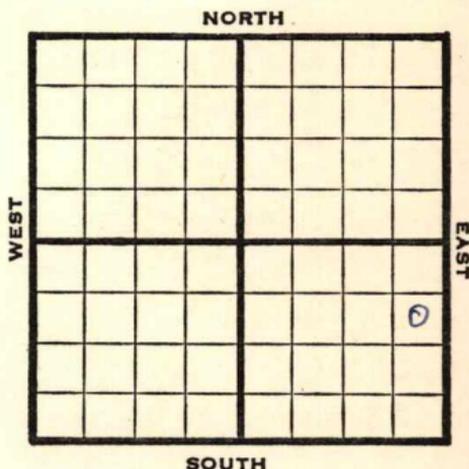

1946

1204

REPORT

7/3 Location

7/9 RUR

7/16 10" @ 92
Drlg 2246'

7/23 Drlg 2242
SD

7/30 **KC 2774**
Miss 3457
TD3458
5" @ 3458 RUST

8/6 TD 3495
25 qts 3482-92 CO

8/13 " "

8/21 **Miss. 3457**
5" @ 3458
25 qts.
TD 3495
Pump 15 Pot.
Grav. 37.0

COMPLETED

KANSAS

Kansas

Pool Name Miscellaneous

Map No. 1 Sec. 22 Twp. 34 R. 2E

Well No. 2 Thiessen

Sterling Petrol. Company

COMPLETED

Contractor

SE NE SE


E 1,1204
SECTION PLAT

990 Ft. from N. Line

 Ft. from S. Line

330 Ft. from E. Line

 Ft. from W. Line

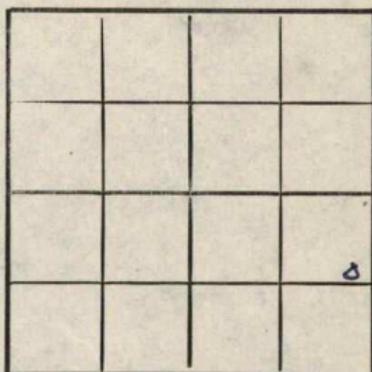

Sumner County

Location _____

Rig up _____

Drilling and Remarks:

Misc 3457
5" @ 3457
209 to.
Pump 150 ft
37 2/3

RECORD

Cased _____ in., _____ ft.

Sand _____

Gas _____

Oil _____

Total Depth 3495'

PRODUCTION

1st 24 hrs. Nat. _____

1st 24 hrs. after shot _____

Gas _____ Cu. Ft.

Dry Hole _____

Abandoned _____

Date

AUG 21 1946 19

S. J. LEWIS

Scout

Kansas Pool Name Miscellaneous

Map No. 1 Sec. 22 Twp. 34 R. 2E

Well No. 2 Thiessen

Sterling Pet. Company

FIRST REPORT

Contractor

SE NE SE

SECTION PLAT

990 Ft. from N. Line

_____ Ft. from S. Line

330 Ft. from E. Line

_____ Ft. from W. Line

			o

Sumner County

Location X

Rig up _____

Drilling and Remarks:

RECORD

Cased _____ in., _____ ft.

Sand _____

Gas _____

Oil _____

Total Depth _____

PRODUCTION

1st 24 hrs. Nat. _____

1st 24 hrs. after shot _____

Gas _____ Cu. Ft.

Dry Hole _____

Abandoned _____

Date

JUL 3 1946 19

S. J. LEWIS

Scout