

KANSAS


FORM 51 IOM 12-46 PETROL

Sumner county

Section 22 Township 34 Range 2-E

Well No. #3, Theissen

Company Sterling Petroleum

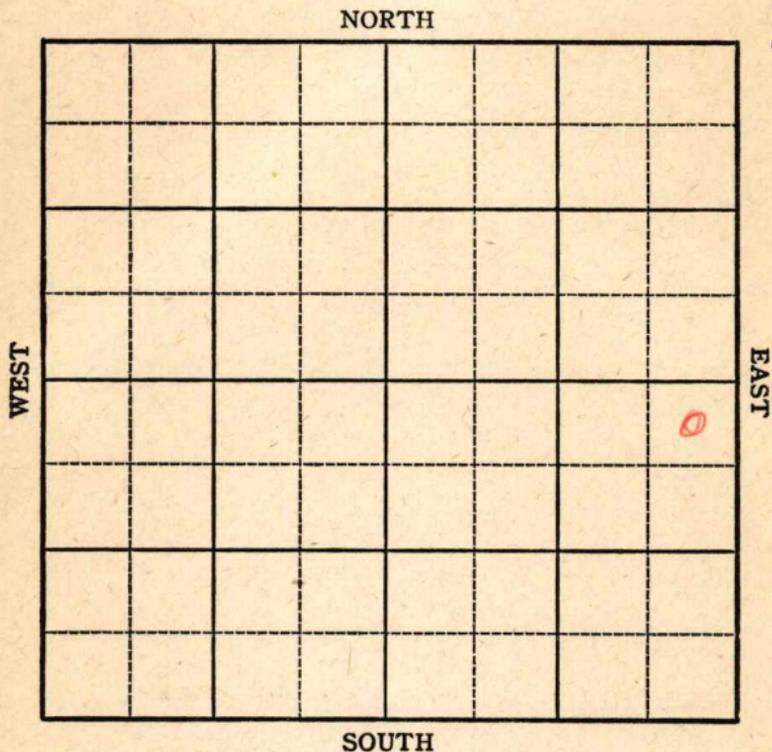

**KANSAS**

Sec. 22 Twp. 34 R. 2-E

Well No. #3, Theissen Farm

Sterling Petroleum Company Company

Miscellaneous


330' Ft. from N. Line

\_\_\_\_\_ Ft. from S. Line

330' Ft. from E. Line

\_\_\_\_\_ Ft. from W. Line

NE SE

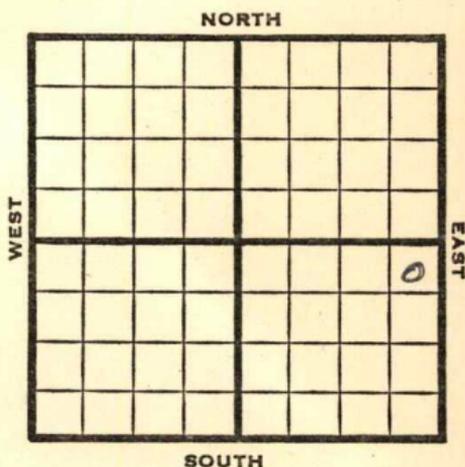

1946

**Elev. 1206'**

REPORT

12/11

Location

12/17

10" @ 105'

Drl g 275'

1947

1/2

**KC 2970'**

**Miss 3458'**

TD 3463'

5" @ 3462', RUST

1/8

" "

1/15

TD 3491'

Pump 200 oil a day

1/22

**Miss 3458'**

5" @ 3462'

TD 3491'

Pump 50 Pot

38 Grav.

**COMPLETED**

Map No. \_\_\_\_\_ Sec. 22 Twp. 34 R. 2E

Well No. 3 Theissen

Sterling Pet. Company

**1<sup>ST</sup> REPORT** Contractor

NE SE

**SECTION PLAT**

330 Ft. from N. Line

\_\_\_\_\_ Ft. from S. Line

330 Ft. from E. Line

\_\_\_\_\_ Ft. from W. Line

			0

Sumner County

Location X

Rig up \_\_\_\_\_

Drilling and Remarks:

**RECORD**

Cased \_\_\_\_\_ in., \_\_\_\_\_ ft.

Sand \_\_\_\_\_

Gas \_\_\_\_\_

Oil \_\_\_\_\_

Total Depth \_\_\_\_\_

**PRODUCTION**

1st 24 hrs. Nat. \_\_\_\_\_

1st 24 hrs. after shot \_\_\_\_\_

Gas \_\_\_\_\_ Cu. Ft.

Dry Hole \_\_\_\_\_

Abandoned \_\_\_\_\_

Date

DEC 1 1 1946 19 \_\_\_\_\_

S. J. LEWIS Scout

Map No. 1 Sec. 22 Twp. 34 R. 2E

Well No. 3 Theissen

Sterling Pet. Company

**COMPLETE**

Contractor

NE SE

*E 11/206*

**SECTION PLAT**

330 Ft. from N. Line

\_\_\_\_\_ Ft. from S. Line

330 Ft. from E. Line

\_\_\_\_\_ Ft. from W. Line

			o

Sumner County

Location \_\_\_\_\_

Rig up \_\_\_\_\_

Drilling and Remarks:

*Miss 3458*

*5" @ 3462*

*Pump 50 ft*

*PSR*

**RECORD**

Cased \_\_\_\_\_ in., \_\_\_\_\_ ft.

Sand \_\_\_\_\_

Gas \_\_\_\_\_

Oil \_\_\_\_\_

Total Depth 3491

**PRODUCTION**

1st 24 hrs. Nat. \_\_\_\_\_

1st 24 hrs. after shot \_\_\_\_\_

Gas \_\_\_\_\_ Cu. Ft.

Dry Hole \_\_\_\_\_

Abandoned \_\_\_\_\_

Date

JAN 22 1947 19

S. J. LEWIS Scout