


Sumner

KANSAS

SECTION 22 TOWNSHIP 34 RANGE 2E

WELL NO. #1 Schwartz-Thiessen Unit

COMPANY Anderson-Prichard

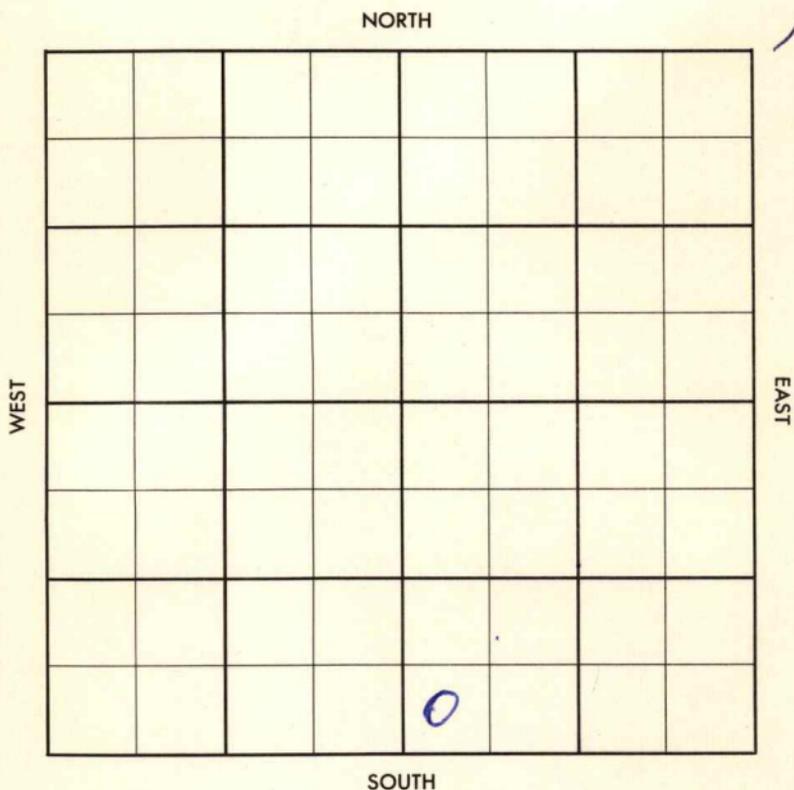

Sumner


KANSAS

SEC. 22	TWP. 34	R. 2E
------------	------------	----------

WELL NO. #1 Schwartz-Thiessen Unit FARM

COMPANY Anderson-Prichard

CONTRACTOR Peel Bros.

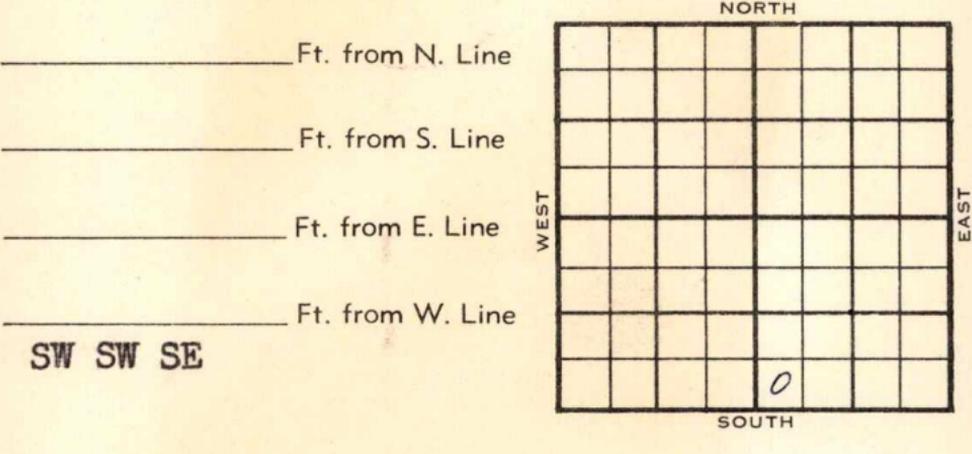

1956	ELEVATION	REPORT
------	-----------	--------

5-2 WOR
6-27 Comm. 5-19-56
8 5/8" @ 126/175 Drlg. 688, 3080,
Ø 3506-19, 7' rec
Ø 3519-43 Fuel rec S.O. 5" 3558 WOC.
PF 128, 3517-20
\$ 110 GFPH - 84% W - 8 hrs Acid fr.
2/2
\$ 22 BFPH, 79% W-6hrs
\$ WBO-17 BWPH-18 hrs S. I.
P. 14 B~~0~~+175 BW 24 hrs.
Stall 2397; H. Lay 2815; K.C. 3002;
Tops Log:
Stall 2397; H. Lay 2814; K.C. 3000;
Ce. Clev 2132; C Clev Sd 2139;
Morrow 3197; M. Bx 3467; K. Cong 3487;
Mz Mi 3515
TD: 3558

COMPLETED

County Sumner Elev. _____
 Sec. 22 Twp. 34 Rgs. 2E
 Company Anderson-Prichard
 Farm Name Schwartz-Thiessen Unit No. 1

TOPS	DEPTH	LOG	DATUM
Anh.			
Tp.			
H.			
Tr.			
Dg.			
Bl.			
L.			
K.C.			
B.K.C.			
Ce.			
C.			
M.			
M.			
K.			
Mz.			
Me.			
V.			
S.			
S.			
A.			
R.			
PE.			
G.			
T.D.			

Loc. in Sec. SW SW SE

Geol. _____
 Contr. Peel Bros.

Pool _____

FIRST REPORT	
MAY 2 '56	0

Date Comm. WOR

MAY 2 1956

Handwritten red scribble

Co.
No.
Sec.
T.
R.

County Summer Elev. _____
 Sec. 22 Twp. 34 Rge. 2E
 Company Anderson-Prichard
 Farm Name Schwartz-Thiessen Unit No. 1

	TOPS	DEPTH	LOG	DATUM
Anh.				
Fp.	<u>Stall</u>	<u>2397</u>	<u>2397</u>	
H.	<u>Lay</u>	<u>2815</u>	<u>2814</u>	
Tr.				
Dg.				
Bl.				
L.				
K.C.		<u>3002</u>	<u>3000</u>	
B.K.C.				
Cc.	<u>Clev</u>		<u>3132</u>	
C.	<u>2d</u>		<u>3139</u>	
M.	<u>new</u>		<u>3197</u>	
M.	<u>By</u>		<u>3467</u>	
K.	<u>Long</u>		<u>2987</u>	
Mz.	<u>N. 10</u>		<u>2815</u>	
Mq.				
V.				
S.				
S.				
A.				
R.				
PE.				
G.				
T.D.			<u>3558</u>	

Loc. in Sec. SW SW SE
 Geol. _____
 Contr. Peel Bros.
 Pool _____

COMPLETE

Date Comm. JUN 27 '56
 W O R MAY 9 '56 MAY 16 '56 MAY 23 '56 5-19-56
8 5/8" 126/175 Ø 688 MAY 29 '56
Ø 3080 JUN 6 '56 \$ 3506-19, T' Rec
\$ 3519-93, Fuel Rec. S.O.
5" 3558 WOC JUN 13 '56 DF¹² 3517-20
\$ 110 G FRH-84%W-8lbs Acidfa.
2/2 \$ 22 BFRH, 79%W-6lbs, \$ 2030-
178lbs^{18hr} ST. JUN 20 '56 JUN 27 '56 P. 14
B0 + 175 BW 24 hrs