


Section 22 Township 34 Range 2E

Well No. 1 Collinson "A"

Company M. B. Armer

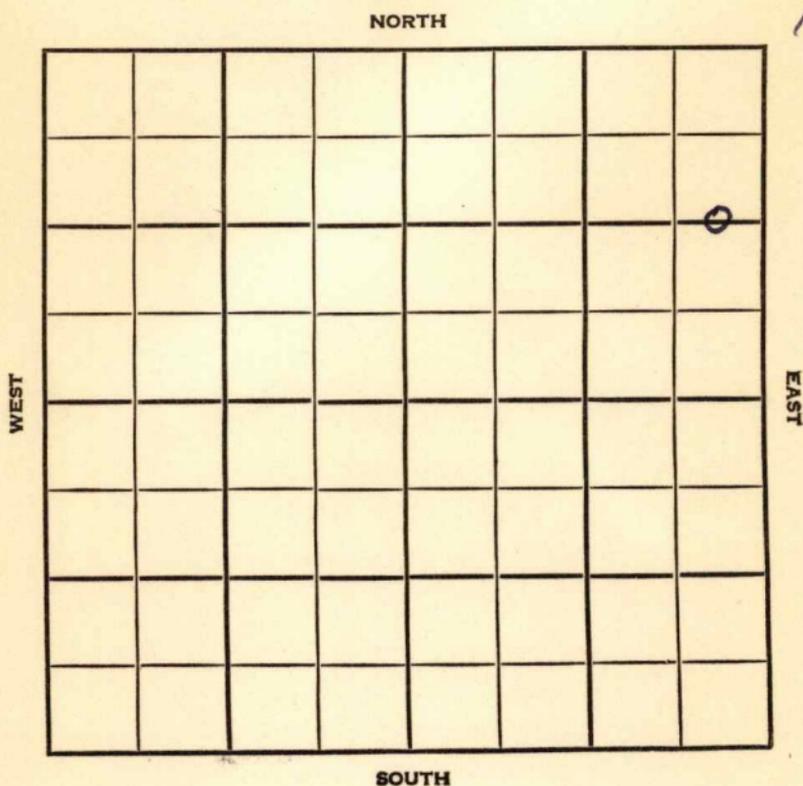

Summer

KANSAS


SEC.	TWP.	R.
22	34	2 E

WELL NO. # 1 Collinson "A" FARM

COMPANY M. B. Armer

CONTRACTOR Cappitt Drlg.

1320 Ft. from N. Line
 _____ Ft. from S. Line
 330 Ft. from E. Line
 _____ Ft. from W. Line

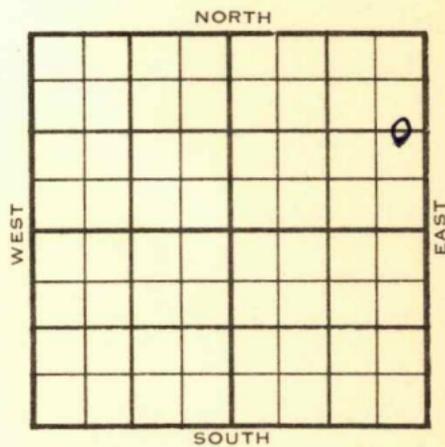

C E $\frac{1}{2}$ E $\frac{1}{2}$ NE

	ELEVATION	REPORT
1954	1203'	

4/27 Spud 4-17-54
 8" @ 109 Layton 2792 KC 2974
 Oswego 3164'
 DST ? Drlg. 3353'

5/5 Spud 4-17-54 D & A TD 3530
 8" @ 109 Layton 2792 KC 2974
 Oswego 3164 Miss 3464
 DST 3466-90 open 1 hr rec 35' STCM
 275# Miss lime 3519
 TD 3530' D & A

ABANDONED

