

Map No. **KANSAS** Sec. 23 Twp. 34 R. 2E


Well No. 1-7 Minean Farm
Harris & Hahn Company

660 Ft. from N. Line

_____ Ft. from S. Line

660 Ft. from E. Line

_____ Ft. from W. Line

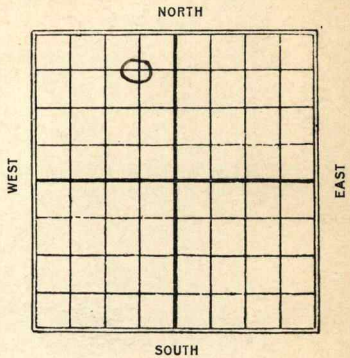

1928

Date	REPORT
3/7	Cellar
3/14	—
3/21	—
3/28	—
4/4	—
4/11	—
4/18	—
4/25	—
5/2	Bldg rig
5/9	Rig
5/16	—
5/23	Rig blew down
5/31	Rig still down.
6/6	Rig down
6/13	Bldg rig + moving in tools.
6/20	—
6/27	no report.
7/3	Rig
7/11	—
7/18	—
7/25	—
8/11	Spud

8/7 - Drlg 712
8/15 - " 1280'
8/22 - TD 1280 fog took
9/5 - T.D. - 1280 - S.D.
9/12 _____
9/19 _____
9/26 _____
10/3 _____
10/10 _____
10/17 _____
10/24 _____
10/31 _____
11/7 _____
11/14 - Skid rig 30' south
pipe collapsed
11/21 _____
11/28 - Drlg 510'
12/5 - " 1070'
12/12 - " 1720'
12/19 - Stream 10" - 1950 TD
12/26 - Drlg 2000'
1929
1/2 - S.D. - 2000' - T.D.
1/9 _____
1/16 - Drlg 2785'
1/23 - " 3150'
1/30 - chat 3450'
show O & G - 3505'
Drlg 3510'
2/6 - UIR 6" - 3550' - T.D.
2/13 - run 6" - 3550'
2/20 - Drlg 3635'
2/27 - Base line 3714'
Top sand 3777' - Sem 5"
3/6 - Sec. line 3825 - 26'
T.D. 3826' - HFW
Dry & Abandoned

MAP NO. **KANSAS** SEC. 23 TWP. 34 R. 2E

WELL NO. 1 Miréau

Harris & Hahn COMPANY

CONTRACTOR

SECTION PLAT

	0		

660 FT. FROM N. LINE

FT. FROM S. LINE

660 FT. FROM E. LINE

FT. FROM W. LINE

ABANDONED

LOCATION _____

RIG UP _____

DRILLING AND REMARKS:

*Oil line 3825
& 3826 NFW*

JJA

RECORD

CASED _____ IN. _____ FT.

SAND _____

GAS _____

OIL _____

TOTAL DEPTH 3826

PRODUCTION

1ST 24 HRS. NAT. _____

1ST 24 HRS. AFTER SHOT _____

GAS _____ CU. FT.

DRY HOLE _____

ABANDONED _____

DATE

MAR 6 - 1929

S. J. LEWIS

192

SCOUT

Summer
KANSAS MAP No. _____ SEC. 23 TWP. 34 R. 2A

WELL No. 10151ean

Harris & Hahn COMPANY

CONTRACTOR

SECTION PLAT

660 FT. FROM N. LINE

_____ FT. FROM S. LINE

660 FT. FROM E. LINE

_____ FT. FROM W. LINE

	0		

ABANDONED

LOCATION _____

RIG UP _____

DRILLING AND REMARKS:

*Oil Line 3825
3826 NAW*

J & H

RECORD

CASED _____ IN., _____ FT.

SAND _____

GAS _____

OIL _____

TOTAL DEPTH 3826

PRODUCTION

1ST 24 HRS. NAT. _____

1ST 24 HRS. AFTER SHOT _____

GAS _____ CU. FT.

DRY HOLE _____

ABANDONED _____

DATE

MAR 6 1929

192

S. J. LEWIS

SCOUT

Map No. **KANSAS** Sec. 28 Twp. 34 R. 2E

Well No. 1 Mircan

Harris & Hahn Company

Contractor

SECTION PLAT

660 Ft. from N. Line

_____ Ft. from S. Line

660 Ft. from E. Line

_____ Ft. from W. Line

	0		

FIRST REPORTS

Location _____

Rig up _____

Drilling and Remarks:

Cellar
Gas test

RECORD

Cased _____ in., _____ ft.

Sand _____

Gas _____

Oil _____

Total Depth _____

PRODUCTION

1st 24 hrs. Nat. _____

1st 24 hrs. after shot _____

Gas _____ Cu. Ft.

Dry Hole _____

Abandoned _____

Date

MAR 7 1928

S. J. LEWIS

Scout