


Section 23 Township 34 Range 2E

Well No. #1 Warner

Company L.C. Smitherman

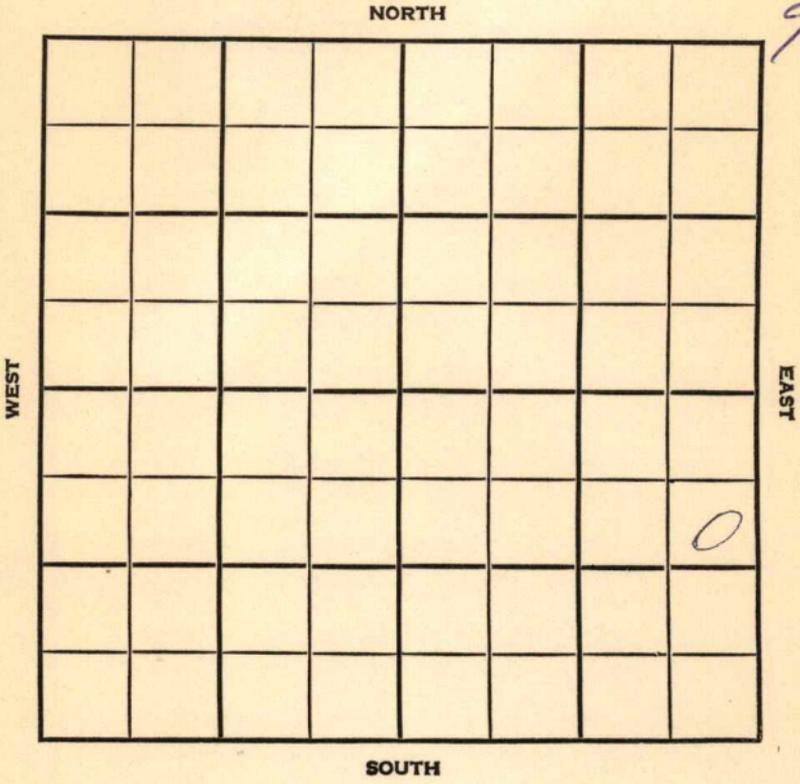

County Sumner Elev. _____
 Sec. 23 Twp. 34 Rge. 2E
 Company L. C. Smitherman
 Farm Name Warner No. 1

TOPS	DEPTH	LOG	DATUM
Anh.			
Tp.			
H.			
Tr.			
Dg.			
Bl.			
L.			
K.C.			
B.K.C.			
Ce.			
C.			
M.			
M.			
K.			
Mz.			
Ma.			
V.			
S.			
S.			
A.			
R.			
PE.			
G.			
T.D.			

Loc. in Sec. SE NE SE

Geol. _____
 Contr. Sorobee

Pool Padgett

FIRST REPORT		
		0
OCT 31 '56		

Date Comm. 10-26-56
8" @ 131/125 d rlg. 1800

~~CONFIDENTIAL~~

~~29~~

Co.

Lse.

No.

Sec.

T.

R.

County Sumner Elev. 1162 DF
 Sec. 23 Twp. 34 Rge. 2E
 Company L. C. Smitherman
 Farm Name Warner No. 1

TOPS	DEPTH	LOG	DATUM	Loc. in Sec.
Anh.				SE NE SE
Tp. <u>604</u>	<u>2742</u>			
H.				
Tr.				
Dg.				Geol.
Bl.				
L.				Concr
K.C.	<u>2926</u>			
B.K.C. <u>clevl</u>	<u>3053</u>			Sorobee
Gr. <u>05w</u>	<u>3121</u>			
Ce.	<u>3252</u>			Pool
M. <u>-c9</u>	<u>3436</u>			
M.				Padgett
K.				
Mz.				ABANDONED
Mo.				
V.				
S.				
S.				
A.				
R.				
Pe.				
G.				
T.D.	<u>3467</u>			

Date Comm. 10-26-56
 8" @ 131/125 d rlg. 1800 NOV 7 '56
D 3200 NOV 13 '56

D & A