


Section 24 Township 34 Range 1E

Well No. #2 Kinlund

Company Four States Oil (Tulsa)

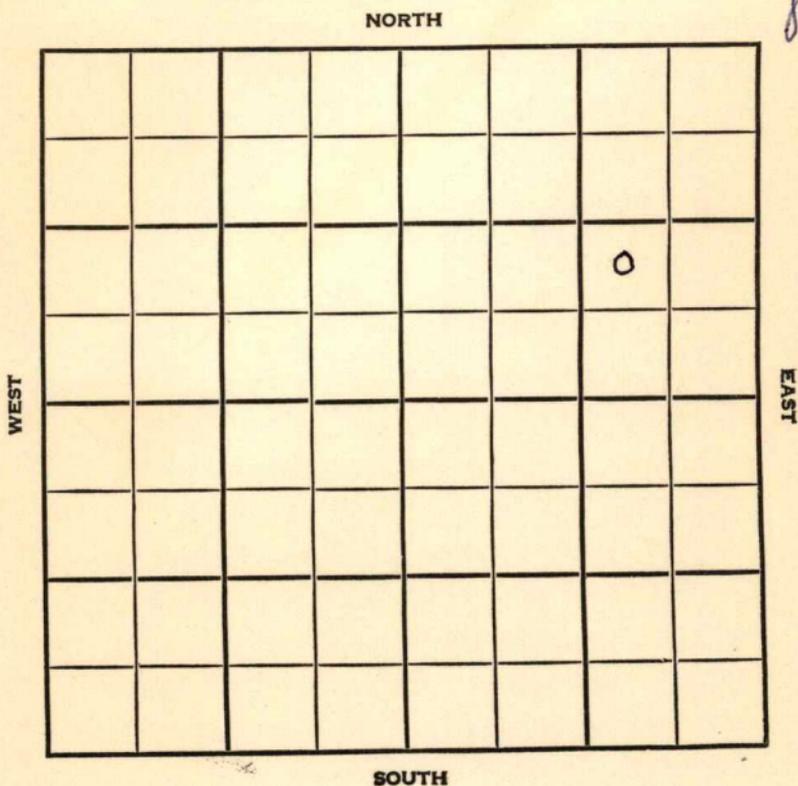

Summer

KANSAS


SEC.	24	TWP.	34	R.	1E
------	----	------	----	----	----

WELL NO. 2 Kinlund FARM

COMPANY Four States Oil

CONTRACTOR Watson
Ashton

_____ Ft. from N. Line
 _____ Ft. from S. Line
 _____ Ft. from E. Line
 _____ Ft. from W. Line

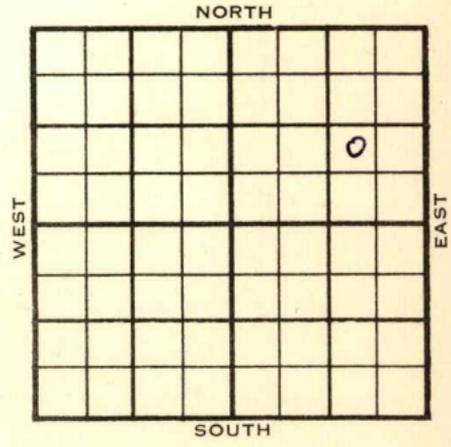

NW SE NE
Simp test

	ELEVATION	REPORT
--	-----------	--------

1955 1194

6/22 R U R

9/28 Comm 6-22-55
 8 5/8" @ 140
 Stal 2457
 H Layton 2884
 KC 2068
 Cleve 3179
 Oswego 3252
 Miss 3542
 Chat 3791
 S 3827
 TD 3832
 5 1/2" @ 3827 DD 3835
 B/1 goph frac Temp Abd.

ABANDONED

County Sumner Elev. _____
 Sec. 24 Twp. 34 Rge. 1E
 Company Four States Oil (Tulsa)
 Farm Name Kinlund No. 2

TOPS	DEPTH	LOG	DATUM	Loc. in Sec.
Anh.				NW SE NE
Tp.				
H.				
Tr.				
Dg.				Simp. test
Bl.				
L.				Geol.
K.C.				Contr.
B.K.C.				Watson
Ce.				
C.				Pool
M.				Ashton
M.				
K.				
Mz.				
Mq.				
V.				
S.				
S.				
A				
R.				
Pe.				
G.				
TD.				

FIRST REPORT
 JUN 22 1915

Date Comm. RUR

Co.
Lse.
No.
Sec.
T.
R.

County Sumner Elev. 1194
 Sec. 24 Twp. 34 Rge. 1E
 Company Four States Oil
 Farm Name Kinlund No. 2

TOPS	DEPTH	LOG	DATUM	Loc. in Sec.																					
Anh.				NW SE NE																					
Tp. <u>ST&I</u>	<u>2457</u>		<u>1263</u>																						
H. <u>Layton</u>	<u>2884</u>		<u>1690</u>																						
Tr.																									
Dg.																									
Bl.																									
L.																									
K.C.	<u>3068</u>		<u>1874</u>	Geol.																					
B.K.C. <u>Cleaveland</u>	<u>3179</u>		<u>1985</u>	Contr.																					
Ce. <u>Oswego</u>	<u>3256</u>		<u>2058</u>	<u>Watson</u>																					
C.				Pool																					
M. <u>iss</u>	<u>3542</u>		<u>2348</u>	<u>Ashton</u>																					
M. <u>Chat</u>	<u>3791</u>		<u>2577</u>																						
K.																									
Mz.																									
Mq.																									
V.																									
S.	<u>3827</u>		<u>2633</u>	<table border="1"> <tr><td></td><td></td><td></td></tr> <tr><td></td><td></td><td></td></tr> <tr><td></td><td></td><td></td></tr> <tr><td></td><td></td><td></td></tr> <tr><td></td><td></td><td></td></tr> <tr><td></td><td></td><td></td></tr> <tr><td></td><td></td><td></td></tr> </table>																					
S.																									
A.																									
R.																									
PE.																									
G.																									
T.D.	<u>3832</u>																								

Date Comm. 6-22-55 SEP 28 1955
8 5/8" @ 140 5 1/2" @ 3827 DD 3835

B/ 1 goph frac Temp. abd.

[Faint red and black markings and bleed-through from the reverse side of the page]