


O.W.W.O.

Section 24 Township 34 Range 1E

Well No. #2 Wolf

Company Ashton O. I.
Flynn Oil

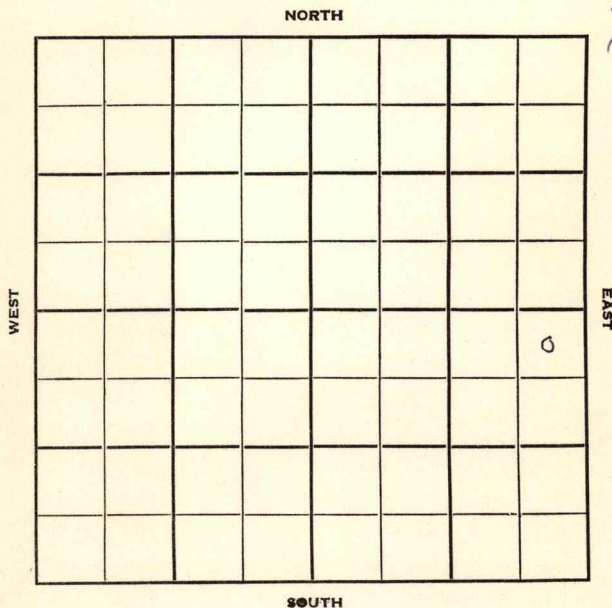

Sec. 24 Twp. 34 R. 1EWell No. #2
#1 WolfAshton Oil
Flynn Oil

Company

Stearns

Contractor


Wildest SW Ashton Pool330' Ft. from N. Line

Ft. from S. Line

330' Ft. from E. Line

Ft. from W. Line

NE NE SE

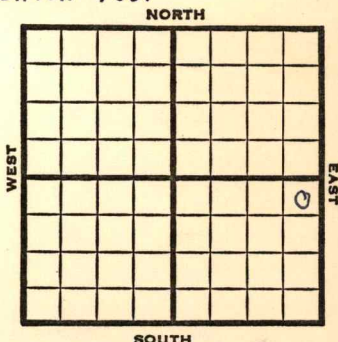

1951

Elev. 1187' REPORT

7/25

Drlg.

8/15

Bpud 7-22-51

D&A TD 3950

8" @ 200

Stal. 2459 Layton 2871

Stain 2871-78 2878-82

DST 2868-82 opn 1 hr

Rec. 300' sw Miss 3538

DST 3540-47 opn 1 hr Rec. 90' socm

90' wtr B. Miss 3763

Simp 3795 Simp sd 3817

DST 3822-26 opn 1 hr

Rec. 10' mud Arb. 3895

TD 3950

D&A

ABANDONED

1954

7/28

O.W.W.O.

Stal 2459' Layton 2871' Miss 3538

B. Miss. 3763 Simp. 3795

Simp sd 3817' Arb. 3895'

OTD 3950 To test Cleve. sd.

9/1

TD 3950' - Oil Well

Stal. 2459', Layton 2871', Miss 3538',

B. Miss 3763', Simp. 3795', Simp sd

3817', Arb. 3895'

OTD 3950'

5" @ 3250' CO 48/3189-3201 GSO&G

frac - F 200 bo Cleve 3178'

Comp. 15 bopd 5% wtr.

COMPLETED

County Sumner State KansasSec. 24 (Blk.) 3 4 (Sur.) 1E Map No.Operator Flynn OilWell No. 1 Farm WolfElev. 1187 Location NE NE SE330 Ft. From N Line SE330 Ft. From E Line Quarter

1st. Report

Completion AUG 15 1951Remarks WildcatSpudding Date 7-22-51Drlg. Data D & A TD 39508" @ 200 Stal. 2459 Layton 2871Stain 2871-78 2878-82 DST 2868-82open 1 hr. Rec. 300' sw Miss. 3538DST 3540-47 open 1 hr. Rec. 90' socm90' water B. Miss. 3763 Simp. 3795Simp. sd. 3817 DST 3822-26 open 1 hr.Rec. 10' mud Arb. 3895 TD 3950D & A

J. E. TYRA

O.W.W.O.

County Sumner State KansasSec. 24 (Blk.) 34 (Sur.) 1E Map No.Operator Ashton OilWell No. 2 Farm WolfElev. 1187 Location NE NE SE

FIRST REPORT

330 Ft. From N Line SE330 Ft. From E Line Quarter1st. Report JUL 28 1954Completion O.W.W.O.Remarks OWWOStearns - Contr.

Spudding Date

Drlg. Data SW Ashton PoolStal. 2459 Layton 2871 Miss. 3538B. Miss. 3763 Simp. 3795 Simp. sd. 3817Arb. 3895 OTD 3950 to test Cleve. sd.

*Carroll
Co & well no
813*

FABEN GILSTRAP