


DX 78-1

Section 24 Township 34 Range 1E

Well No. 1 Wolf

Company Fred Ayesch

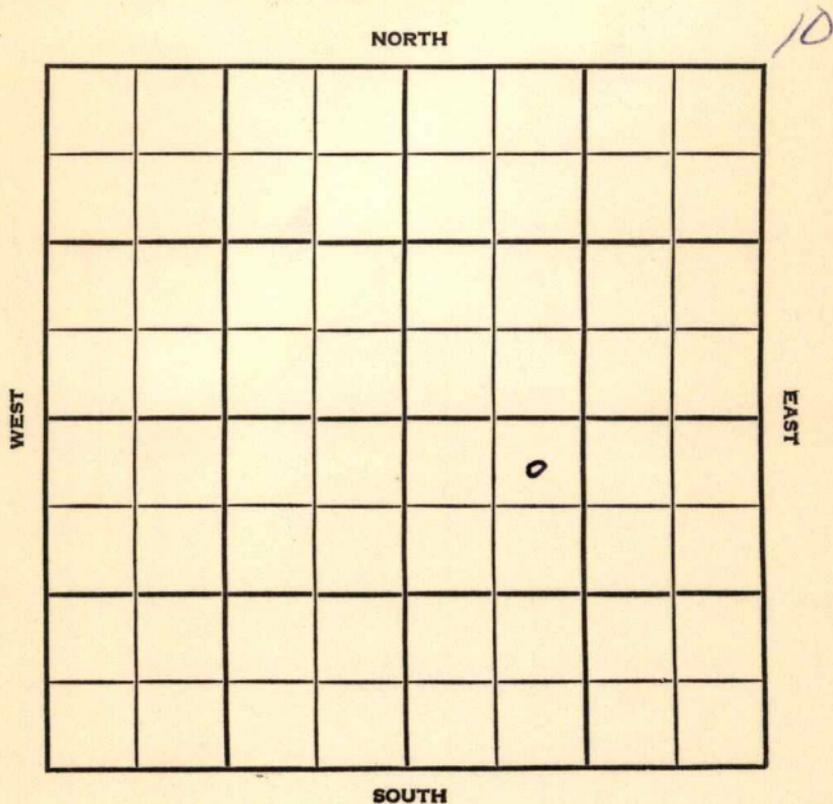

SEC. 24 TWP. 34 R. 1E

WELL NO. 1 Wolf FARM COMPANY

Fred Ayesch

CONTRACTOR Kriswell Contr.


Wildcat

330 Ft. from N. Line

Ft. from S. Line

Ft. from E. Line

990 Ft. from W. Line

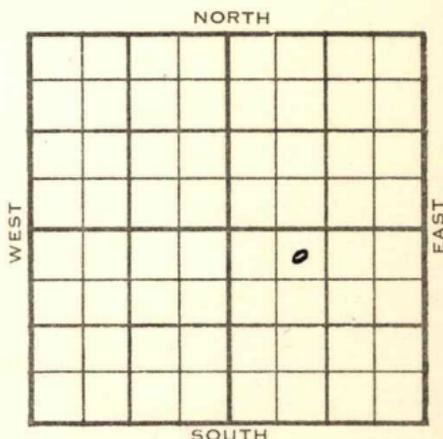

NE NW SE

	ELEVATION	REPORT
1954	1183'	

6/9 **Stal. 2465 Layton 2879**
 KC 3070 DST 3113-23 open 1 hr/
 Rec. 300' mcsw
Cleveland 3191 Cored 3193-3234
 Rec. 18' sat. sd. 20' spotted sd. 3' sh.

Oswego 3259-64
 TD. 3264

7/28 Oil Well
 TD 3264'
Stal. 2465', Layton 2879', KC 3070'
 DST 3113-23, opn 1 hr., rec. 300' mcsw
Cleveland 3191'
 Cored 3193-3234', rec. 18' s at sd,
 20' spotted sd, 3' ~~sh~~ shale,
Oswego 3259-64'
 TD 3264'
 5" @ 3264'
 CO to 3264, perf 3190-3208, oil & wtr
 sq. 250 A
 Comp. 22 bopd

COMPLETED

County Summer State Kansas
 Sec. 24 (Blk.) 34 (Sur.) 1E Map No.
 Operator Fred Ayesch
 Well No. 1 Farm Wolf
 Elev. _____ Location NE NW SE

330 Ft. From N Line SE
990 Ft. From W Line Quarter
 Ist. Report JUN 9 1954
 Completion _____
 Remarks Kriswell - Contr.
 Spudding Date _____

Drlg. Data Wildcat
Stal. 2465 Layton 2879 KC 3070
DST 3113-23 open 1 hr. Rec. 300' mesw
Cleveland 3191 Cored 3193-3234 Rec. 18'
sat. sd. 20' spotted sd. 3' sh.
Oswego 3259-64 TD 3264


County Sumner State Kansas

Sec. 24 (Blk. 34 (Sur. Rge.) 1E) Map No.

Operator Fred Ayesch

Well No. 1 Farm Wolf

Elev. 1183 Location NE NW SE

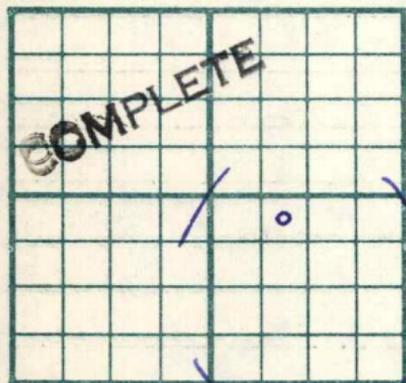

330 Ft. From N Line SE

990 Ft. From W Line Quarter

1st. Report

Completion JUL 28 1954

Remarks Wildcat

Kriswell - Contr.

Spudding Date

Drlg. Data Oil well TD 3264

Stal. 2465 Layton 2879 KC 3070

DST 3113-23 open 1 hr. Rec. 300' mcsw

Cleveland 3191 Cored 3193-3234 Rec.

18' sat. sd. 20' spotted sd. 3' shale

Oswego 3259-64 TD 3264 5" @ 3264

CO to 3264 perf. 3190-3208 oil & wtr.

sq. 250 A Comp. 22 bopd