


Section 24 Township 34 Range 1 E

Well No. # 3 Wolf

Company Ashton Oil

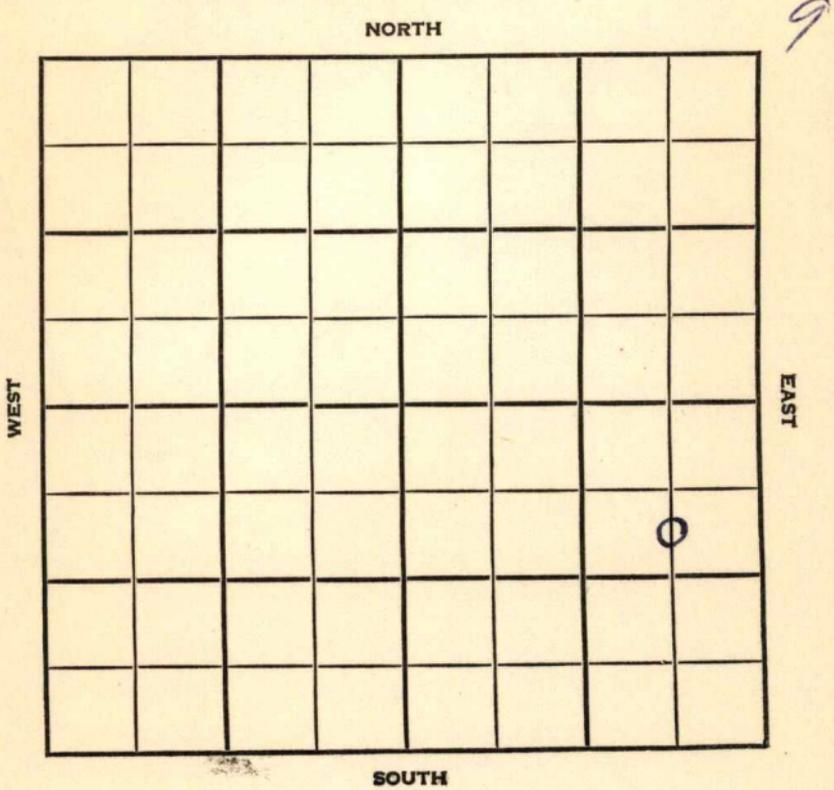

Sumner

KANSAS

SEC.	TWP.	R.
24	34	1E

WELL NO. **3 Wolf** FARM

COMPANY **Ashton Oil**


CONTRACTOR **Kriswell**

990 _____ Ft. from N. Line

_____ Ft. from S. Line

660 _____ Ft. from E. Line

_____ Ft. from W. Line

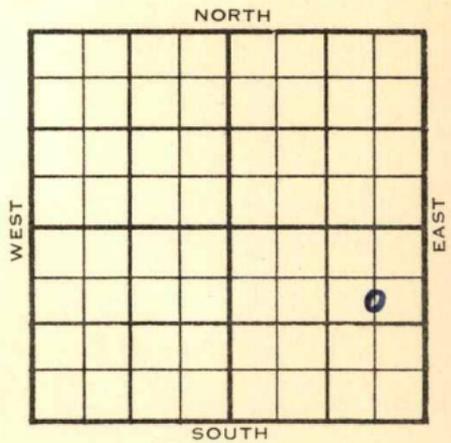

C S/2 NE SE

	ELEVATION	REPORT
1955		

1/12 Spud 1-9-55
8" @ 100'
D rlg. 800'

